

CARD MUST BE TYPED

State of Kansas
NOTICE OF INTENTION TO DRILL

CARD MUST BE SIGNED

(see rules on reverse side)

Starting Date: AUGUST 11 1984
month day year

API Number 15- 065-22,037-00

OPERATOR: License # 5430

NW SE NW Sec 36 Twp 8 S, Rge 25 East West
(location)

3630 Ft North from Southeast Corner of Section
3630 Ft West from Southeast Corner of Section
(Note: Locate well on Section Plat on reverse side)

Nearest lease or unit boundary line 990 feet.
County GRAHAM
Lease Name SCHAMBERGER Well# 1

Name ENERGY THREE, INC.
Address P.O. Box 1505
City/State/Zip GREAT BEND, KS. 67530
Contact Person DOUGLAS MEYER
Phone AC316-792-5968

CONTRACTOR: License # 5836
Name BIG THREE DRILLING, INC.
City/State P.O. Box 52, GORHAM, KS. 67640

Domestic well within 330 feet: yes no
Municipal well within one mile: yes no

Well Drilled For: Well Class: Type Equipment:
 Oil Swd Infield Mud Rotary
 Gas Inj Pool Ext. Air Rotary
 OWWO Expl Wildcat Cable

Depth to Bottom of fresh water 175 feet
Lowest usable water formation DAKOTA
Depth to Bottom of usable water 1250 feet
Surface pipe by Alternate: 1 2
Surface pipe to be set 240 feet
Conductor pipe if any required _____ feet
Ground surface elevation _____ feet MSL
This Authorization Expires 2-3-85
Approved By 8-3-84 *[Signature]*

If OWWO: old well info as follows:
Operator _____
Well Name _____
Comp Date _____ Old Total Depth _____
Projected Total Depth 4000 feet
Projected Formation at TD LANSING-KC
Expected Producing Formations LANSING-KC

I certify that we will comply with K.S.A. 55-101, et seq., plus eventually plugging hole to K.C.C. specifications.


Date 8-2-84 Signature of Operator or Agent

[Signature: Douglas P Meyer] Title EXEC. VICE-PRES.

[Handwritten: mhc/NOTE 8/3/84]

Must be filed with the K.C.C. five (5) days prior to commencing well
This card void if drilling not started within six (6) months of date received by K.C.C.

A Regular Section of Land
1 Mile = 5,280 Ft.

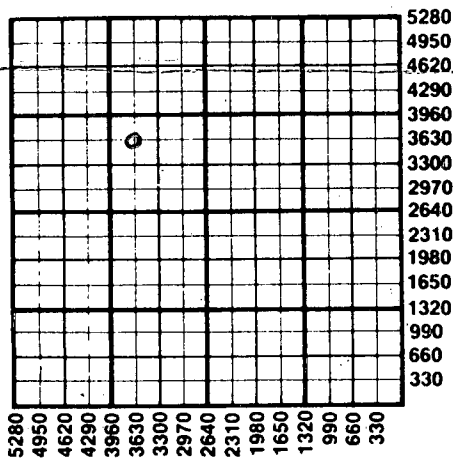

Important procedures to follow :

1. Notify District office before setting surface casing.
2. Set surface casing by circulating cement to the top.
3. File completion forms ACO-1 with K.C.C. within 90 days of well completion, following instructions on ACO-1, side 1, and including copies of wireline logs.
4. Notify District office 48 hours prior to old well workover or re-entry.
5. Prior to plugging, prepare a plugging plan, then obtain agreement from the appropriate district office for an approved plugging plan.
6. Submit plugging report (CP-4) to K.C.C. after plugging is completed.
7. Obtain an approved injection docket number before disposing of salt water.
8. Notify K.C.C. within 10 days when injection commences or terminates.
9. If an alternate 2 completion, cement in the production pipe from below any usable water to surface within 120 days of spud date.

RECEIVED
STATE CORPORATION COMMISSION

AUG 03 1984
8-3-1984
CONSERVATION DIVISION
Wichita, Kansas

State Corporation Commission of Kansas
Conservation Division
200 Colorado Derby Building
Wichita, Kansas 67202
(316) 263-3238