

CARD MUST BE TYPED

State of Kansas  
**NOTICE OF INTENTION TO DRILL**  
(see rules on reverse side)

CARD MUST BE SIGNED

Starting Date: January 20, 1986  
month day year

API Number 15- 179-20,858-00-00

OPERATOR: License # 4151  
Name Crane Petroleum, Inc.  
Address 5600 S. Syracuse Cir., Ste. 205-A  
City/State/Zip Englewood, Colorado 80110  
Contact Person John Listone  
Phone 316/792-4356 or 316/793-5326 (Home)

NW SW NW ... Sec 31 Twp 8 S, Rge 26  East  
(location)  West  
3480 Ft North from Southeast Corner of Section  
4950 Ft West from Southeast Corner of Section  
(Note: Locate well on Section Plat on reverse side)

CONTRACTOR: License # 5302  
Name Red Tiger Drilling Company  
City/State Wichita, Kansas 67202

Nearest lease or unit boundary line 330 feet.  
County Sheridan  
Lease Name Schamberger Well# 1

Well Drilled For: Well Class: Type Equipment:  
 Oil  Swd  Infield  Mud Rotary  
 Gas  Inj  Pool Ext.  Air Rotary  
 OWWO  Wildcat  Cable

Domestic well within 330 feet:  yes  no  
Municipal well within one mile:  yes  no

If OWWO: old well info as follows:

Operator .....  
Well Name .....  
Comp Date ..... Old Total Depth .....  
Projected Total Depth 4,000 feet  
Projected Formation at TD Base Kansas City  
Expected Producing Formations Lansing-Kansas City

Depth to Bottom of fresh water 200 feet  
Lowest usable water formation Dakota  
Depth to Bottom of usable water 1300 feet  
Surface pipe by Alternate: 1  2   
Surface pipe to be set 250 feet  
Conductor pipe if any required ..... feet  
Ground surface elevation 2574 feet MSL.  
This Authorization Expires 7-16-86  
Approved By 1-16-86 *RC*

I certify that we will comply with K.S.A. 55-101, et seq., plus eventually plugging hole to K.C.C. specifications.

CRANE PETROLEUM, INC.


Date 1-13-86 Signature of Operator or Agent Orin C. Crane Title President

*pch/rdh*

Must be filed with the K.C.C. five (5) days prior to commencing well  
This card void if drilling not started within six (6) months of date received by K.C.C.

**Important procedures to follow:**

**A Regular Section of Land  
1 Mile = 5,280 Ft.**

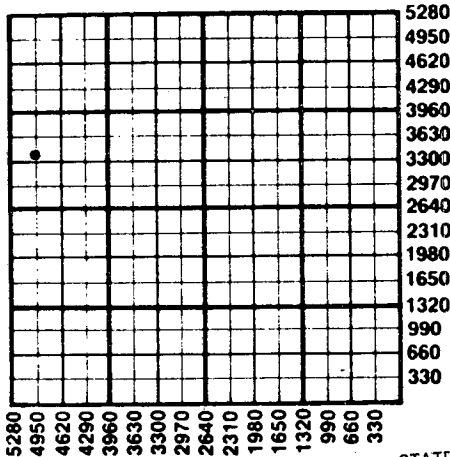

1. Notify District office before setting surface casing.
2. Set surface casing by circulating cement to the top.
3. File completion forms ACO-1 with K.C.C. within 90 days of well completion, following instructions on ACO-1, side 1, and including copies of wireline logs.
4. Notify District office 48 hours prior to old well workover or re-entry.
5. Prior to plugging, prepare a plugging plan, then obtain agreement from the appropriate district office for an approved plugging plan.
6. Submit plugging report (CP-4) to K.C.C. after plugging is completed.
7. Obtain an approved injection docket number before disposing of salt water.
8. Notify K.C.C. within 10 days when injection commences or terminates.
9. If an alternate 2 completion, cement in the production pipe from below any usable water to surface within 120 days of spud date.

RECEIVED

STATE CORPORATION COMMISSION

State Corporation Commission of Kansas

Conservation Division

200 Colorado Derby Building

Wichita, Kansas 67202

(316) 263-3238

01-16-1986

JAN 16 1986

CONSERVATION DIVISION  
Wichita, Kansas