

NOTICE OF INTENTION TO DRILL

(see rules on reverse side)

Starting Date May 20, 1987 month day year

API Number 15- 179-20,894-00-00

OPERATOR: License # 04134

NW SE NE Sec. 26 Twp. 8 S, Rg. 26 West

Name Douglas P. Meyer Oil Investments

Address 135 West 4th Street

City/State/Zip Russell, Kansas 67665

Contact Person Doug Meyer

Phone (913) 483-4501

3630 Ft. from South Line of Section

990 Ft. from East Line of Section

(Note: Locate well on Section Plat on reverse side)

Nearest lease or unit boundary line 330 feet

County Sheridan

CONTRACTOR: License # 5671

Lease Name Pratt Well # 1

Name Revlin Drilling Company Inc.

City/State Russell, Kansas

Ground surface elevation 2520 feet MSL

Domestic well within 330 feet: yes X no

Municipal well within one mile: yes X no

Well Drilled For: Well Class: Type Equipment:

X Oil SWD Infield X Mud Rotary

Gas Inj Pool Ext. Air Rotary

OWWO Expl Wildcat Cable

Depth to bottom of fresh water 200

Depth to bottom of usable water 1300

Surface pipe by Alternate: 1 2 X

Surface pipe planned to be set 250

Conductor pipe required 0

Projected Total Depth 3950 feet

Formation B/ LKC

If OWWO: old well info as follows:

Operator

Well Name

Comp Date Old Total Depth

I certify that well will comply with K.S.A. 55-101, et seq., plus eventually plugging hole to KCC specifications.

Date 4-29-87 Signature of Operator or Agent Douglas P. Meyer Title Owner/Operator

For KCC Use:

Conductor Pipe Required 220 feet; Minimum Surface Pipe Required 40 feet per Alt.

This Authorization Expires 11-1-87 Approved By 5-1-87


Handwritten signatures and initials at the bottom right of the page.

Must be filed with the K.C.C. five (5) days prior to commencing well
This card void if drilling not started within six (6) months of date received by K.C.C.

Important procedures to follow:

1. Notify District office before setting surface casing.
2. Set surface casing by circulating cement to the top.
3. File completion forms ACO-1 with K.C.C. within 90 days of well completion, following instructions on ACO-1, side 1, and including copies of wireline logs.
4. Notify District office 48 hours prior to old well workover or re-entry.
5. Prior to filing Intent, prepare a proposed plugging plan in case well is D & A, then obtain approval of plan when calling district office prior to setting surface pipe.
6. Submit plugging report (CP-4) to K.C.C. after plugging is completed.
7. Obtain an approved injection docket number before disposing of salt water.
8. Notify K.C.C. within 10 days when injection commences or terminates.
9. If an alternate 2 completion, cement in the production pipe from below any usable water to surface within 120 days of spud date.

**A Regular Section of Land
1 Mile = 5,280 Ft.**

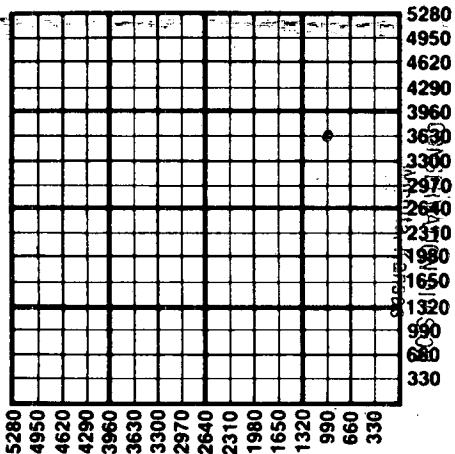

MAY 1 1987

STATE CORPORATION COMMISSION
RECEIVED

05-01-1987

State Corporation Commission of Kansas
Conservation Division
200 Colorado Derby Building,
Wichita, Kansas 67202
(316) 263-3238