

NOTICE OF INTENTION TO DRILL

(see rules on reverse side)

Starting Date 10 month 6 day 86 year

API Number 15-143-20,005-00-00

OPERATOR: License # 4474
Name William C. Wakefield
Address P.O. Box 548
City/State/Zip Winfield, Kansas 67156
Contact Person William C. Wakefield
Phone 316-221-0415

SE SW SW Sec 6 Twp 9 S, Rg 3 West
330 Ft. from South Line of Section
4290 Ft. from East Line of Section

(Note: Locate well on Section Plat on reverse side)

CONTRACTOR: License # 5671
Name Revlin Drilg., Inc.
City/State Box 293 Russell, Kansas 67665

Nearest lease or unit boundary line 330 feet
County Otawa
Lease Name Nelson Well # 1
Ground surface elevation n/a est 1380' feet MSL
Domestic well within 330 feet: yes x no

Well Drilled For: Well Class: Type Equipment:
x Oil SWD x Infield x Mud Rotary
Gas Inj Pool Ext Air Rotary
OWWO Expl Wildcat Cable

Municipal well within one mile: yes x no
Depth to bottom of fresh water 200
Depth to bottom of usable water 250
Surface pipe by Alternate: 1 x 2
Surface pipe planned to be set 250
Conductor pipe required
Projected Total Depth 3900 feet
Formation Arbuckle

If OWWO: old well info as follows:

Operator
Well Name
Comp Date Old Total Depth

I certify that well will comply with K.S.A. 55-101, et seq., plus eventually plugging hole to KCC specifications.

Date 10-2-86 Signature of Operator or Agent Paula J. Gibson Title Agent

For KCC Use:

Conductor Pipe Required feet; Minimum Surface Pipe Required 250 feet per Alt. 1 X


This Authorization Expires 9-3-87 Approved By Lett 10-3-86

Must be filed with the K.C.C. five (5) days prior to commencing well  
This card void if drilling not started within six (6) months of date received by K.C.C.

**Important procedures to follow:**

1. Notify District office before setting surface casing.
2. Set surface casing by circulating cement to the top.
3. File completion forms ACO-1 with K.C.C. within 90 days of well completion, following instructions on ACO-1, side 1, and including copies of wireline logs.
4. Notify District office 48 hours prior to old well workover or re-entry.
5. Prior to filing Intent, prepare a proposed plugging plan in case well is D & A, then obtain approval of plan when calling district office prior to setting surface pipe.
6. Submit plugging report (CP-4) to K. C. C. after plugging is completed.
7. Obtain an approved injection docket number before disposing of salt water.
8. Notify K.C.C. within 10 days when injection commences or terminates.
9. If an alternate 2 completion, cement in the production pipe from below any usable water to surface within 120 days of spud date.

**A Regular Section of Land  
1 Mile = 5,280 Ft.**

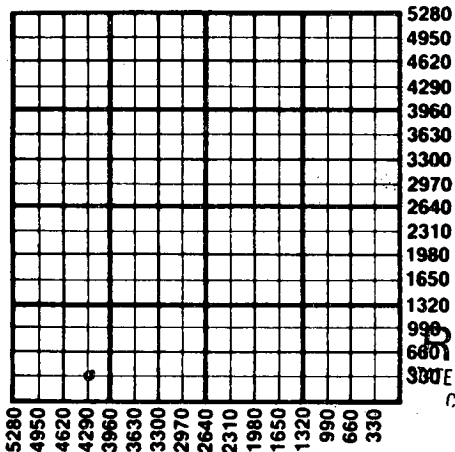

**RECEIVED**  
STATE CORPORATION COMMISSION  
CONS. DIV. WICHITA, KS

10-3-86  
OCT 3 1986

State Corporation Commission of Kansas  
Conservation Division  
200 Colorado Derby Building  
Wichita, Kansas 67202  
(316) 263-3238