

For KCC Use: 11-19-01
 Effective Date: 11-19-01
 District #: 4
 SGA? Yes No

KANSAS CORPORATION COMMISSION
 OIL & GAS CONSERVATION DIVISION
NOTICE OF INTENT TO DRILL

Form C-1
 September 1999
Form must be Typed
Form must be Signed
All blanks must be Filled

Must be approved by KCC five (5) days prior to commencing well

Expected Spud Date 11/26/2001
 month day year

Spot 30' S. & 50' E of East
W/2 - SE - SE Sec. 19 Twp. 9 S. R. 12 West
630 feet from (S) (circle one) Line of Section
940 feet from (E) (circle one) Line of Section
 Is SECTION Regular Irregular?

OPERATOR: License# 5056 ✓
 Name: F.G. Holl Company, L.L.C.
 Address: 6427 E. Kellogg, P.O. BOX 780167,
Wichita, Kansas 67278-0167
 Contact Person: Franklin R. Greenbaum
 Phone: (316) 684-8481

(Note: Locate well on the Section Plat on reverse side)
 County: Osborne
 Lease Name: REXROAT Well #: 1-19
 Field Name: None

CONTRACTOR: License# 5142 ✓
 Name: Sterling Drilling Company, Rig #4

Is this a Prorated / Spaced Field? Yes No ✓
 Target Formation(s): Lansing

Well Drilled For:	Well Class:	Type Equipment:
<input checked="" type="checkbox"/> Oil	<input type="checkbox"/> Enh Rec	<input checked="" type="checkbox"/> Mud Rotary ✓
<input type="checkbox"/> Gas	<input type="checkbox"/> Storage	<input type="checkbox"/> Air Rotary
<input type="checkbox"/> OWWO	<input type="checkbox"/> Disposal	<input type="checkbox"/> Cable
<input type="checkbox"/> Seismic; # of Holes	<input type="checkbox"/> Wildcat	
<input type="checkbox"/> Other	<input type="checkbox"/> Other	

Nearest Lease or unit boundary: 330' (?) ✓

Ground Surface Elevation: 1909 feet MSL ✓

Water well within one-quarter mile: Yes No ✓

Public water supply well within one mile: Yes No ✓

Depth to bottom of fresh water: 180' - 300' ✓

Depth to bottom of usable water: 1260' - 500' B/Dakota ✓

Surface Pipe by Alternate: 1 X 2

Length of Surface Pipe Planned to be set: 200' ✓

Length of Conductor Pipe required: None

Projected Total Depth: 3200'

Formation at Total Depth: Lansing

If OWWO: old well information as follows:

Operator: _____
 Well Name: _____
 Original Completion Date: _____ Original Total Depth: _____

Directional, Deviated or Horizontal wellbore? Yes No ✓

If Yes, true vertical depth: _____

Bottom Hole Location: _____

KCC DKT #: _____

Water Source for Drilling Operations:

Well _____ Farm Pond X Other _____

DWR Permit #: (Contractor will apply)

(Note: Apply for Permit with DWR)

Will Cores be taken? Yes No ✓

If Yes, proposed zone: _____

AFFIDAVIT

RECEIVED

The undersigned hereby affirms that the drilling, completion and eventual plugging of this well will comply with K.S.A. 55-1011, et seq.

It is agreed that the following minimum requirements will be met:

1. Notify the appropriate district office **prior** to spudding of well;
2. A copy of the approved notice of intent to drill **shall be** posted on each drilling rig;
3. The minimum amount of surface pipe as specified below **shall be set** by circulating cement to the top; in all cases surface pipe **shall be set** through all unconsolidated materials plus a minimum of 20 feet into the underlying formation.
4. If the well is dry hole, an agreement between the operator and the district office on plug length and placement is necessary **prior to plugging**;
5. The appropriate district office will be notified before well is either plugged or production casing is cemented in;
6. If an ALTERNATE II COMPLETION, production pipe shall be cemented from below any usable water to surface within **120 days** of spud date. **In all cases, NOTIFY district office** prior to any cementing.

I hereby certify that the statements made herein are true and to the best of my knowledge and belief.

Franklin R. Greenbaum

Date: 11/7/2001 Signature of Operator or Agent: _____ Title: Exploration Manager

For KCC Use ONLY

API # 15 - 141-20352-0000
 Conductor pipe required NONE feet
 Minimum surface pipe required 200' feet per Alt. X(2)
 Approved by: Dlw 11-14-01
 This authorization expires: 5-14-02
 (This authorization void if drilling not started within 6 months of effective date.)
 Spud date: _____ Agent: _____

Remember to:

- File Drill Pit Application (form CDP-1) with Intent to Drill;
- File Completion Form ACO-1 within 120 days of spud date;
- File acreage attribution plat according to field proration orders;
- Notify appropriate district office 48 hours prior to workover or re-entry;
- Submit plugging report (CP-4) after plugging is completed;
- Obtain written approval before disposing or injecting salt water.

19
09
12w

IN ALL CASES PLOT THE INTENDED WELL ON THE PLAT BELOW

Plat of acreage attributable to a well in a prorated or spaced field

If the intended well is in a prorated or spaced field, please fully complete this side of the form. If the intended well is in a prorated or spaced field complete the plat below showing that the well will be properly located in relationship to other wells producing from the common source of supply. Please show all the wells and within 1 mile of the boundaries of the proposed acreage attribution unit for gas wells and within 1/2 mile of the boundaries of the proposed acreage attribution unit for oil wells.

API No. 15 - _____
Operator: _____
Lease: _____
Well Number: _____
Field: _____

Number of Acres attributable to well: _____
QTR / QTR / QTR of acreage: W/2 - SE - SE


Location of Well: County: _____
_____ 630 feet from (S) / N (circle one) Line of Section
_____ 940 feet from (E) / W (circle one) Line of Section
Sec. 19 Twp. 9 S. R. 12 East West

Is Section Regular or _____ Irregular


If Section is Irregular, locate well from nearest corner boundary.
Section corner used: ___ NE ___ NW ___ SE ___ SW

PLAT

*(Show location of the well and shade attributable acreage for prorated or spaced wells.)
(Show footage to the nearest lease or unit boundary line.)*

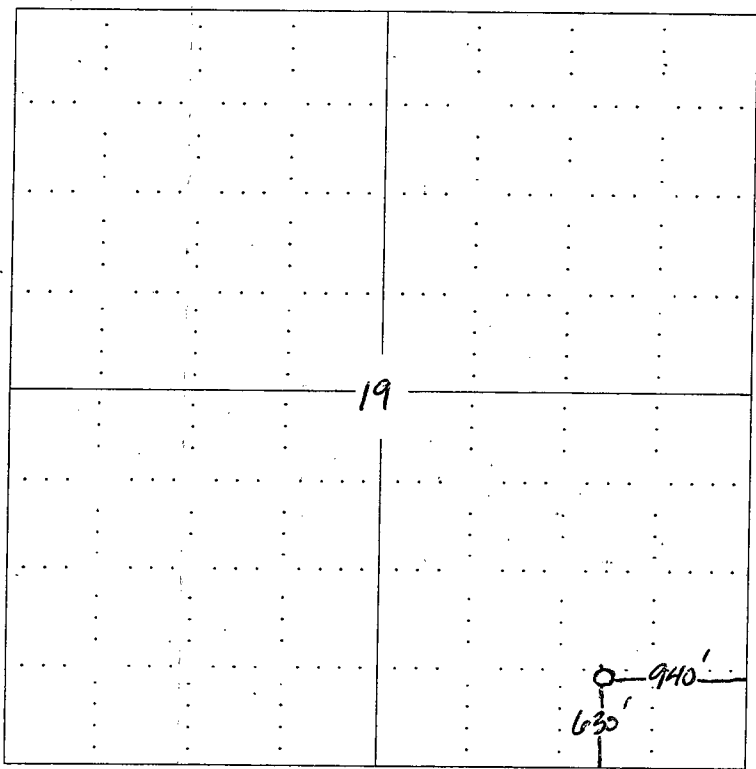

RECEIVED
NOV 08 2001
KCC WICHITA

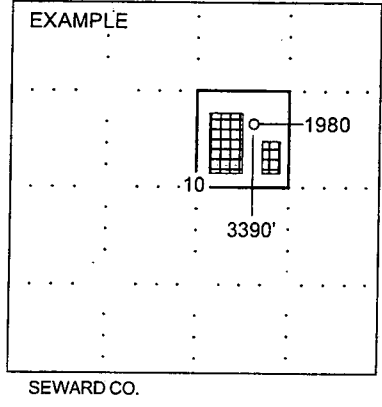

NOTE: In all cases locate the spot of the proposed drilling locaton.

In plotting the proposed location of the well, you must show:

1. The manner in which you are using the depicted plat by identifying section lines, i.e. 1 section, 1 section with 8 surrounding sections, 4 sections, etc.
2. The distance of the proposed drilling location from the section's south / north and east / west.
3. The distance to the nearest lease or unit boundary line.
4. If proposed location is located within a prorated or spaced field a certificate of acreage attribution plat must be attached: (CO-7 for oil wells; CG-8 for gas wells).