

CARD MUST BE TYPED

State of Kansas  
**NOTICE OF INTENTION TO DRILL**

CARD MUST BE SIGNED

(see rules on reverse side)

Starting Date: ..... 01 05 85  
month day year 5'25"

API Number 15- 179-20,794-00-00

**OPERATOR:** License # 6033  
Name Murfin Drilling Company  
Address 250 N. Water, Suite 300  
City/State/Zip Wichita, KS 67202  
Contact Person Jack Goss  
Phone 316-267-3241

C. NW SW NE Sec 26 Twp 8 S, Rge 27  
(location)  East  West

3630 Ft North from Southeast Corner of Section  
2310 Ft West from Southeast Corner of Section  
(Note: Locate well on Section Plat on reverse side)

**CONTRACTOR:** License # 6033  
Name Murfin Drilling Company  
City/State Wichita, KS 67202

Nearest lease or unit boundary line ..... 1650 feet.  
County Sheridan

Lease Name G. Brown Well# 11-315

Domestic well within 330 feet:  yes  no correction

Municipal well within one mile:  yes  no 11-35  
DSS  
10-18-05

**Well Drilled For:** **Well Class:** **Type Equipment:**  
 Oil  Swd  Infield  Mud Rotary  
 Gas  Inj  Pool Ext.  Air Rotary  
 OWWO  Expl  Wildcat  Cable

Depth to Bottom of fresh water ..... 150 feet

Lowest usable water formation ..... Dakota

Depth to Bottom of usable water ..... 1350 feet

Surface pipe by Alternate: 1  2

Surface pipe to be set ..... 270 feet

Conductor pipe if any required ..... N/A feet

Ground surface elevation ..... feet MSL

This Authorization Expires ..... 7-4-85

Approved By ..... 1-4-85 [Signature]

If OWWO: old well info as follows:  
Operator .....  
Well Name .....  
Comp Date ..... Old Total Depth .....  
Projected Total Depth ..... 4100 feet  
Projected Formation at TD ..... BKC  
Expected Producing Formations ..... LKC

I certify that we will comply with K.S.A. 55-101, et seq., plus eventually plugging hole to K.C.C. specifications.

Date Jan. 4, 1985 Signature of Operator or Agent

[Signature] Title Ass't. Drilling Manager  
Jack E. Goss, Agent for Operator

MHC/UDHE 1-4-85


Must be filed with the K.C.C. five (5) days prior to commencing well  
This card void if drilling not started within six (6) months of date received by K.C.C.

RECEIVED  
STATE CORPORATION COMMISSION

JAN 4 1985

1-4-85

A Regular Section of Land  
1 Mile or 5,280 Ft.

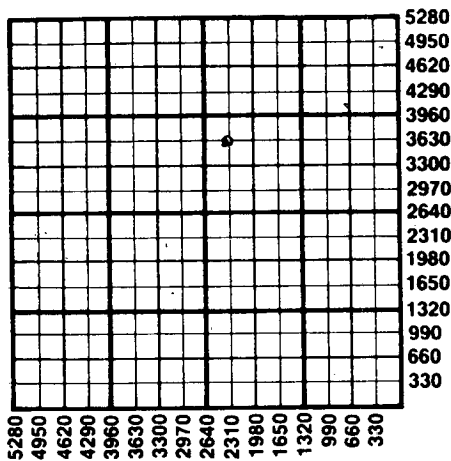

2

**Important procedures to follow :**

1. Notify District office before setting surface casing.
2. Set surface casing by circulating cement to the top.
3. File completion forms ACO-1 with K.C.C. within 90 days of well completion, following instructions on ACO-1, side 1, and including copies of wireline logs.
4. Notify District office 48 hours prior to old well workover or re-entry.
5. Prior to plugging, prepare a plugging plan, then obtain agreement from the appropriate district office for an approved plugging plan.
6. Submit plugging report (CP-4) to K.C.C. after plugging is completed.
7. Obtain an approved injection docket number before disposing of salt water.
8. Notify K.C.C. within 10 days when injection commences or terminates.
9. If an alternate 2 completion, cement in the production pipe from below any usable water to surface within 120 days of spud date.

State Corporation Commission of Kansas  
Conservation Division  
200 Colorado Derby Building  
Wichita, Kansas 67202  
(316) 263-3238