

NOTICE OF INTENTION TO DRILL

(see rules on reverse side)

Expected Spud Date March 28, 1987
month, day year

API Number 15- 179-20,891-0000

OPERATOR: License # 6039
Name L. D. Drilling, Inc.
Address Route 1, Box 183-B
City/State/Zip Great Bend, KS 67530
Contact Person L. D. Davis
Phone 316-793-3051

N/2 NW NW Sec 33 Twp 8 S, Rg 29 X East
4950 Ft. from South Line of Section
4620 Ft. from East Line of Section

(Note: Locate well on Section Plat on reverse side)

CONTRACTOR: License # 5864
Name LOBO Drilling Co.
City/State Great Bend, KS 67530

Nearest lease or unit boundary line 330 feet
County Sheridan
Lease Name Reitcheck Well # 1
Ground surface elevation 2795 (estimate) feet MSL

Well Drilled For: Well Class: Type Equipment:
X Oil --- Storage --- Infield X Mud Rotary
--- Gas --- Inj --- Pool Ext. --- Air Rotary
--- OWWO --- Expl X Wildcat --- Cable

Domestic well within 330 feet: --- yes X no
Municipal well within one mile: --- yes X no
Depth to bottom of fresh water: 200
Depth to bottom of usable water: 1600
Surface pipe by Alternate: 1 2 X
Surface pipe planned to be set: 275'
Conductor pipe required: None
Projected Total Depth: 4150 feet
Formation: BKC

If OWWO: old well info as follows:

Operator
Well Name
Comp Date Old Total Depth

I certify that well will comply with K.S.A. 55-101, et seq., plus eventually plugging hole to KCC specifications.

Date 3-18-87 Signature of Operator or Agent J. M. Vess Title

For KCC Use:

Conductor Pipe Required feet; Minimum Surface Pipe Required 250 feet per Alt. 40

This Authorization Expires 9-20-87 Approved By 3-20-87


Handwritten signatures and initials:
J. M. Vess
pet / pu

Must be filed with the K.C.C. five (5) days prior to commencing well
This card void if drilling not started within six (6) months of date received by K.C.C.

Important procedures to follow:

1. Notify District office before setting surface casing.
2. Set surface casing by circulating cement to the top.
3. File completion forms ACO-1 with K.C.C. within 120 days of well spud date, following instructions on ACO-1, side 1, and including copies of wireline logs.
4. Notify District office 48 hours prior to old well workover or re-entry.
5. Prior to filing Intent, prepare a proposed plugging plan in case well is D & A, then obtain approval of plan when calling district office prior to setting surface pipe.
6. Submit plugging report (CP-4) to K.C.C. after plugging is completed.
7. Obtain an approved injection docket number before disposing of salt water.
8. Notify K.C.C. within 10 days when injection commences or terminates.
9. If an alternate 2 completion, cement in the production pipe from below any usable water to surface within 120 days of spud date.

A Regular Section of Land 1 Mile = 5,280 Ft.

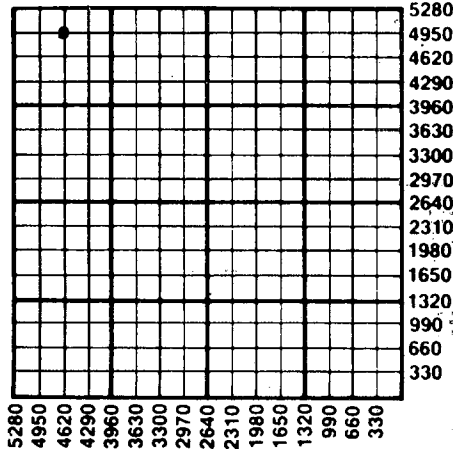

MAR 20 1987

CONSERVATION DIVISION
Wichita, Kansas

329-87

State Corporation Commission of Kansas
Conservation Division
200 Colorado Derby Building
Wichita, Kansas 67202-1212
(316) 263-3238