

CARD MUST BE TYPED

State of Kansas

CARD MUST BE SIGNED

NOTICE OF INTENTION TO DRILL \* CORRECTED COPY - changed

(see rules on reverse side)

lease name

Expected Spud Date..... 11 10 87  
month day year

API Number 15- 179-20,904-00-00

OPERATOR: License # 5135  
Name John O. Farmer, Inc.  
Address P.O. Box 352  
City/State/Zip Russell, KS 67665  
Contact Person Samuel Farmer  
Phone 913-483-3144

NW NE SE Sec. 33 Twp. 8 S, Rg. 29 X East West  
2310 Ft. from South Line of Section  
990 Ft. from East Line of Section

(Note: Locate well on Section Plat on reverse side)

CONTRACTOR: License # 220  
Name John O. Farmer, Inc.  
City/State Russell, KS 67665

Nearest lease or unit boundary line 990 feet  
County Sheridan  
\* Lease Name Reinert "A" Well # 1

Well Drilled For: Well Class: Type Equipment:  
X Oil Storage Infield X Mud Rotary  
Gas Inj Pool Ext Air Rotary  
OWWO Expl X Wildcat Cable

Ground surface elevation 2835 est. feet MSL  
Domestic well within 330 feet: \_\_\_yes Xno  
Municipal well within one mile: \_\_\_yes Xno  
Depth to bottom of fresh water 200  
Depth to bottom of usable water 1650  
Surface pipe by Alternate: 1 \_\_\_ 2 X  
Surface pipe planned to be set 250  
Conductor pipe required None  
Projected Total Depth 4200 feet  
Formation Lansing

If OWWO: old well info as follows:

Operator  
Well Name  
Comp Date Old Total Depth

I certify that well will comply with K.S.A. 55-101, et seq., plus eventually plugging hole to KCC specifications.

Date 8-5-87 Signature of Operator or Agent Sam Farmer Title Geologist

For KCC Use:

Conductor Pipe Required ..... feet; Minimum Surface Pipe Required ..... feet per Alt. 1 (2)  
This Authorization Expires ..... Approved By DR 8-7-87 orig. received 7-28-87


was: RSMW #1

Must be filed with the K.C.C. five (5) days prior to commencing well  
 This card void if drilling not started within six (6) months of date received by K.C.C.

**Important procedures to follow:**

1. Notify District office before setting surface casing.
2. Set surface casing by circulating cement to the top.
3. File completion forms ACO-1 with K.C.C. within 120 days of well spud date, following instructions on ACO-1, side 1, and including copies of wireline logs.
4. Notify District office 48 hours prior to old well workover or re-entry.
5. Prior to filing Intent, prepare a proposed plugging plan in case well is D & A, then obtain approval of plan when calling district office prior to setting surface pipe.
6. Submit plugging report (CP-4) to K.C.C. after plugging is completed.
7. Obtain an approved injection docket number before disposing of salt water.
8. Notify K.C.C. within 10 days when injection commences or terminates.

**A Regular Section of Land**  
**1 Mile = 5,280 Ft.**

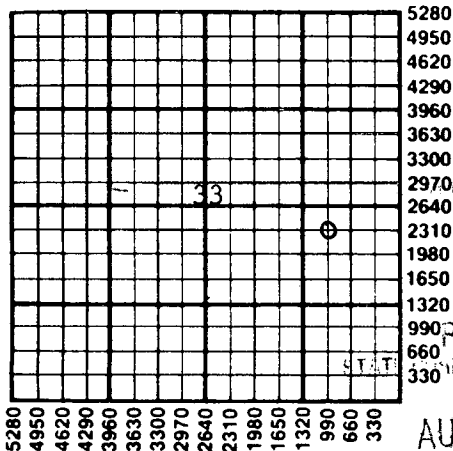

RECEIVED

AUG 6 1987

CONSERVATION DIVISION  
 Wichita, Kansas

State Corporation Commission of Kansas  
 Conservation Division  
 200 Colorado Derby Building  
 Wichita, Kansas 67202-1212  
 (316) 263-3238