

NOTICE OF INTENTION TO DRILL

(see rules on reverse side)

Starting Date NOVEMBER 19 1985 month day year

API Number 15-163-22,813-00-00 CENTER S/2 NW SW Sec. 33 Twp. 9 S, Rg. 16 X West 1650 Ft. from South Line of Section 4620 Ft. from East Line of Section

OPERATOR: License # 5430 Name ENERGY THREE, INC. Address P.O. Box 1505 City/State/Zip GREAT BEND, KANSAS 67530 Contact Person CHARLES DIXON Phone AC 316-792-5968

(Note: Locate well on Section Plat on reverse side)

CONTRACTOR: License # 5836 Name BIG THREE DRILLING, INC. City/State BOX 52, GORHAM, KS. 67640

Nearest lease or unit boundary line 660 feet County Rooks Lease Name CONGER Well # 1 Ground surface elevation feet MSL Domestic well within 330 feet: yes X no Municipal well within one mile: yes X no Surface pipe by Alternate: 1 X 2 Depth to bottom of fresh water 100 Depth to bottom of usable water 800 Surface pipe planned to be set 800 Projected Total Depth 3550 feet Formation ARBUCKLE

Well Drilled For: Well Class: Type Equipment: X Oil SWD Infield X Mud Rotary Gas Inj Pool Ext Air Rotary OWWO Expl X Wildcat Cable

If OWWO: old well info as follows:

Operator Well Name Comp Date Old Total Depth

I certify that well will comply with K.S.A. 55-101, et seq., plus eventually plugging hole to KCC specifications.

Rec'd/11/20/85

cementing will be done immediately upon setting production casing.

Date 11-7-85 Signature of Operator or Agent Title EXECUTIVE VICE-PRES.

For KCC Use:

Conductor Pipe Required feet; Minimum Surface Pipe Required feet per Alt. 2 This Authorization Expires 5-8-86 Approved By 11-8-85


11-8-85

Must be filed with the K.C.C. five (5) days prior to commencing well  
This card void if drilling not started within six (6) months of date received by K.C.C.  
CONSERVATION DIVISION

NOV 8 1985

A Regular Section of Land  
1 Mile = 5,280 Ft.

RECEIVED  
STATE CORPORATION COMMISSION

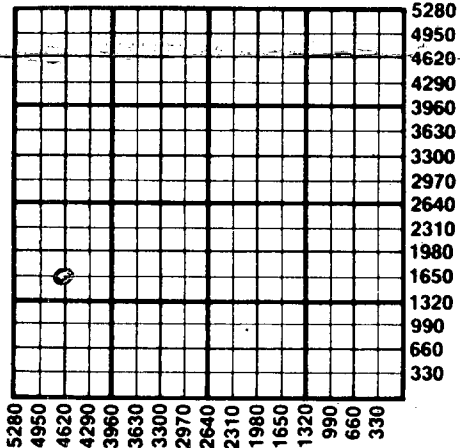

Important procedures to follow:

1. Notify District office before setting surface casing.
2. Set surface casing by circulating cement to the top.
3. File completion forms ACO-1 with K.C.C. within 90 days of well completion, following instructions on ACO-1, side 1, and including copies of wireline logs.
4. Notify District office 48 hours prior to old well workover or re-entry.
5. Prior to filing Intent, prepare a proposed plugging plan in case well is D & A, then obtain approval of plan when calling district office prior to setting surface pipe.
6. Submit plugging report (CP-4) to K.C.C. after plugging is completed.
7. Obtain an approved injection docket number before disposing of salt water.
8. Notify K.C.C. within 10 days when injection commences or terminates.
9. If an alternate 2 completion, cement in the production pipe from below any usable water to surface within 120 days of spud date.

State Corporation Commission of Kansas  
Conservation Division  
200 Colorado Derby Building  
Wichita, Kansas 67202  
(316) 263-3238