

CARD MUST BE TYPED

State of Kansas
NOTICE OF INTENTION TO DRILL
(see rules on reverse side)

CARD MUST BE SIGNED

Starting Date: 7-20-85
month day year

API Number 15- 163-22,699-00-00

OPERATOR: License # 9476
Name G-D Oil Operations / Glen Drotts
Address P.O. Box 441
City/State/Zip Hays, KS 67601
Contact Person Glen Drotts
Phone 913-628-3560

SE . SW . NE Sec 14. . Twp 9. . S, Rge .20. East
(location) West
2970 Ft North from Southeast Corner of Section
1650 Ft West from Southeast Corner of Section
(Note: Locate well on Section Plat on reverse side)

CONTRACTOR: License # 9087
Name R. & C. Drilling Co., Inc.
City/State Hays, Kansas

Nearest lease or unit boundary line 330 feet.
County Rooks
Lease Name Lambert Well# 1
Domestic well within 330 feet: yes no
Municipal well within one mile: yes no

Well Drilled For: Well Class: Type Equipment:
 Oil Swd Infield Mud Rotary
 Gas Inj Pool Ext. Air Rotary
 OWWO Expl Wildcat Cable

Depth to Bottom of fresh water 100 feet
Lowest usable water formation Dakota
Depth to Bottom of usable water 900 feet
Surface pipe by Alternate: 1 2
Surface pipe to be set 200 feet
Conductor pipe if any required NA feet
Ground surface elevation NA feet MSL
This Authorization Expires 12-3-85
Approved By 6-3-85

If OWWO: old well info as follows:
Operator
Well Name
Comp Date Old Total Depth
Projected Total Depth 3800 feet
Projected Formation at TD Arbuckle
Expected Producing Formations Arbuckle


I certify that we will comply with K.S.A. 55-101, et seq., plus eventually plugging hole to K.C.C. specifications. Production string will be immediately cemented.

Date 5-31-85 Signature of Operator or Agent R. L. Finnesy Title R. L. Finnesy, Contractor

Must be filed with the K.C.C. five (5) days prior to commencing well
This card void if drilling not started within six (6) months of date received by K.C.C.

Important procedures to follow :

**A Regular Section of Land
1 Mile = 5,280 Ft.**

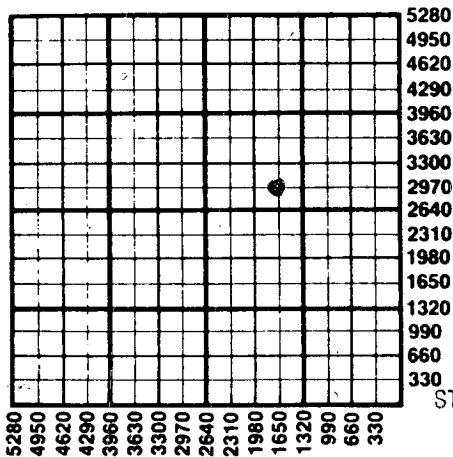

1. Notify District office before setting surface casing.
2. Set surface casing by circulating cement to the top.
3. File completion forms ACO-1 with K.C.C. within 90 days of well completion, following instructions on ACO-1, side 1, and including copies of wireline logs.
4. Notify District office 48 hours prior to old well workover or re-entry.
5. Prior to plugging, prepare a plugging plan, then obtain agreement from the appropriate district office for an approved plugging plan.
6. Submit plugging report (CP-4) to K.C.C. after plugging is completed.
7. Obtain an approved injection docket number before disposing of salt water.
8. Notify K.C.C. within 10 days when injection commences or terminates.

RECEIVED

9. If an alternate 2 completion, cement in the production pipe from below and disable water to surface within 120 days of spud date.

JUN 03 1985
06-03-1985
CONSERVATION DIVISION
Wichita, Kansas

State Corporation Commission of Kansas
Conservation Division
200 Colorado Derby Building
Wichita, Kansas 67202
(316) 263-3238