

CARD MUST BE TYPED

State of Kansas
NOTICE OF INTENTION TO DRILL
(see rules on reverse side)

CARD MUST BE SIGNED

Starting Date: Jan. 15, 1985
month day year

API Number 15- 163-22,598-00-00

OPERATOR: License # 9087
Name R. & C. Drilling Co., Inc.
Address P.O. Box 296
City/State/Zip Hays, KS 67601
Contact Person R. L. Finney
Phone 913-625-4548

NW NE NE Sec. 1. Twp. 9. S, Rge. 18. East West
(location)
.4950 Ft North from Southeast Corner of Section
.990 Ft West from Southeast Corner of Section
(Note: Locate well on Section Plat on reverse side)

CONTRACTOR: License # Company Tools
Name
City/State

Nearest lease or unit boundary line 330 feet.
County Rooks
Lease Name Buenning Well# 3
Domestic well within 330 feet: yes no
Municipal well within one mile: yes no

Well Drilled For: Well Class: Type Equipment:
 Oil Swd Infield Mud Rotary
 Gas Inj Pool Ext. Air Rotary
 OWWO Expl Wildcat Cable

Depth to Bottom of fresh water 100 feet
Lowest usable water formation Dakota
Depth to Bottom of usable water 800 feet
Surface pipe by Alternate: 1 2
Surface pipe to be set 200 feet
Conductor pipe if any required NA feet
Ground surface elevation NA feet MSL
This Authorization Expires 6-20-85
Approved By 12-20-84

If OWWO: old well info as follows:

Operator
Well Name
Comp Date Old Total Depth
Projected Total Depth 3450 feet
Projected Formation at TD Arbuckle
Expected Producing Formations Arbuckle

I certify that we will comply with K.S.A. 55-101, et seq., plus eventually plugging hole to K.C.C. specifications.

Date 12-19-84 Signature of Operator or Agent

R. J. Finney


Title President

mhc/udme 12/19/84

Must be filed with the K.C.C. five (5) days prior to commencing well
 This card void if drilling not started within six (6) months of date received by K.C.C.

Important procedures to follow :

**A Regular Section of Land
 1 Mile = 5,280 Ft.**

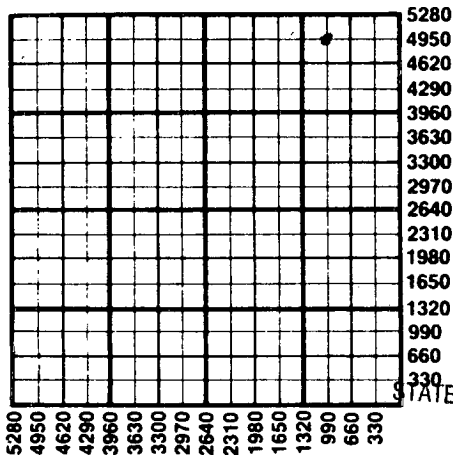

1. Notify District office before setting surface casing.
2. Set surface casing by circulating cement to the top.
3. File completion forms ACO-1 with K.C.C. within 90 days of well completion, following instructions on ACO-1, side 1, and including copies of wireline logs.
4. Notify District office 48 hours prior to old well workover or re-entry.
5. Prior to plugging, prepare a plugging plan, then obtain agreement from the appropriate district office for an approved plugging plan.
6. Submit plugging report (CP-4) to K.C.C. after plugging is completed.
7. Obtain an approved injection docket number before disposing of salt water.
8. Notify K.C.C. within 10 days when injection commences or terminates.

RECEIVED

STATE CORPORATION COMMISSION
 If an alternate 2 completion, cement in the production pipe from below
 any usable water to surface within 120 days of spud date.

12-20-84

DEC 20 1984

CONSERVATION DIVISION
 Wichita, Kansas

State Corporation Commission of Kansas
 Conservation Division
 200 Colorado Derby Building
 Wichita, Kansas 67202
 (316) 263-3238