

CARD MUST BE TYPED

State of Kansas
NOTICE OF INTENTION TO DRILL

CARD MUST BE SIGNED

(see rules on reverse side)

Starting Date: December 4, 1984
month day year

API Number 15- 163-22,580-0000

OPERATOR: License # 5428

NE NE SW Sec 2 Twp 9 S, Rge 18
(location) East West

Name Graves Drilling Co., Inc.

Address 910 Union Center

City/State/Zip Wichita, Kansas 67202

Contact Person Betty Brandt

Phone 316-265-7233

2310 Ft North from Southeast Corner of Section
2970

..... Ft West from Southeast Corner of Section
(Note: Locate well on Section Plat on reverse side)

CONTRACTOR: License # 5381

Nearest lease or unit boundary line 2310 feet.

County Rooks

Lease Name Meyers Well# 1

Domestic well within 330 feet : yes no

Municipal well within one mile : yes no

Name Big Springs Drilling, Inc.

City/State Wichita, Kansas 67202

Well Drilled For: Well Class: Type Equipment:

- | | | | |
|---|-------------------------------|---|--|
| <input checked="" type="checkbox"/> Oil | <input type="checkbox"/> Swd | <input type="checkbox"/> Infield | <input checked="" type="checkbox"/> Mud Rotary |
| <input type="checkbox"/> Gas | <input type="checkbox"/> Inj | <input type="checkbox"/> Pool Ext. | <input type="checkbox"/> Air Rotary |
| <input type="checkbox"/> OWWO | <input type="checkbox"/> Expl | <input checked="" type="checkbox"/> Wildcat | <input type="checkbox"/> Cable |

If OWWO: old well info as follows:

Operator

Well Name

Comp Date Old Total Depth

Projected Total Depth 3550 feet

Projected Formation at TD Arbuckle

Expected Producing Formations Arbuckle

Depth to Bottom of fresh water 60 feet

Lowest usable water formation Dakota

Depth to Bottom of usable water 900 feet

Surface pipe by Alternate : 1 2

Surface pipe to be set 240 feet

Conductor pipe if any required none feet

Ground surface elevation approx. 1990 feet MSL

This Authorization Expires 5-30-85

Approved By 11-30-84 [Signature]

I certify that we will comply with K.S.A. 55-101, et seq., plus eventually plugging hole to K.C.C. specifications.

Date .. 11-30-84 ... Signature of Operator or Agent

[Signature]

Title Landman


MHC/WJHE 11/30/84

Must be filed with the K.C.C. five (5) days prior to commencing well
This card void if drilling not started within six (6) months of date received by K.C.C.

RECEIVED
STATE CORPORATION COMMISSION

11-30-84

NOV 30 1984
A Regular Section of Land
1 Mile = 5,280 Ft.
CONSERVATION DIVISION
Wichita, Kansas

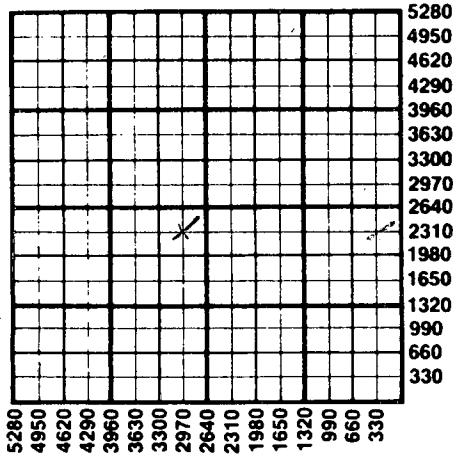

Important procedures to follow:

1. Notify District office before setting surface casing.
2. Set surface casing by circulating cement to the top.
3. File completion forms ACO-1 with K.C.C. within 90 days of well completion, following instructions on ACO-1, side 1, and including copies of wireline logs.
4. Notify District office 48 hours prior to old well workover or re-entry.
5. Prior to plugging, prepare a plugging plan, then obtain agreement from the appropriate district office for an approved plugging plan.
6. Submit plugging report (CP-4) to K.C.C. after plugging is completed.
7. Obtain an approved injection docket number before disposing of salt water.
8. Notify K.C.C. within 10 days when injection commences or terminates.
9. If an alternate 2 completion, cement in the production pipe from below any usable water to surface within 120 days of spud date.

State Corporation Commission of Kansas
Conservation Division
200 Colorado Derby Building
Wichita, Kansas 67202
(316) 263-3238