

NOTICE OF INTENTION TO DRILL

(see rules on reverse side)



Starting Date June 22, 1988 month day year

API Number 15-163-23,006-00-00

OPERATOR: License # 5652
Name Mustang Companies, Inc.
Address Highway 281 South, P.O. Drawer 1609
City/State/Zip Great Bend, KS 67530
Contact Person Jim Meroney
Phone 316-792-7323

C SE SE 11 10 19 East
Sec. 11 Twp. 10 S, Rg. 19 West
660 Ft. from South Line of Section
4620 660 Ft. from East Line of Section

(Note: Locate well on Section Plat on reverse side)

CONTRACTOR: License # 4083
Name Western Kansas
City/State Hays, Kansas

Nearest lease or unit boundary line 660 feet
County Rooks
Lease Name Pirotte Well # 6
Ground surface elevation feet MSL
Domestic well within 330 feet: yes X no
Municipal well within one mile: yes X no
Depth to bottom of fresh water 70 feet
Depth to bottom of usable water 900 feet
Surface pipe by Alternate: 1 2 X
Surface pipe planned to be set 225 feet
Conductor pipe required none
Projected Total Depth 3750 feet
Formation Arbuckle

Well Drilled For: Well Class: Type Equipment:
X Oil SWD Infield Mud Rotary
Gas Inj Pool Ext Air Rotary
OWWO Expl Wildcat Cable

If OWWO: old well info as follows:
Operator
Well Name
Comp Date Old Total Depth

I certify that well will comply with K.S.A. 55-101, et seq., plus eventually plugging hole to KCC specifications.
Date June 17, 1988 Signature of Operator or Agent Title Agent

For KCC Use:
Conductor Pipe Required feet; Minimum Surface Pipe Required 200 feet per Alt. X 2
This Authorization Expires 12-17-88 Approved By 6-17-88


EFFECTIVE DATE: 6-22-88

Must be filed with the K.C.C. five (5) days prior to commencing well
This card void if drilling not started within six (6) months of date received by K.C.C.

Important procedures to follow:

1. Notify District office before setting surface casing.
 2. Set surface casing by circulating cement to the top.
 3. File completion forms ACO-1 with K.C.C. within 90 days of well completion, following instructions on ACO-1, side 1, and including copies of wireline logs.
 4. Notify District office 48 hours prior to old well workover or re-entry.
 5. Prior to filing Intent, prepare a proposed plugging plan in case well is D & A, then obtain approval of plan when calling district office prior to setting surface pipe.
 6. Submit plugging report (CP-4) to K.C.C. after plugging is completed.
 7. Obtain an approved injection docket number before disposing of salt water.
9. If an alternate 2 completion, cement in the production pipe from below any usable water to surface within 120 days of spud date.

**A Regular Section of Land
1 Mile = 5,280 Ft.**

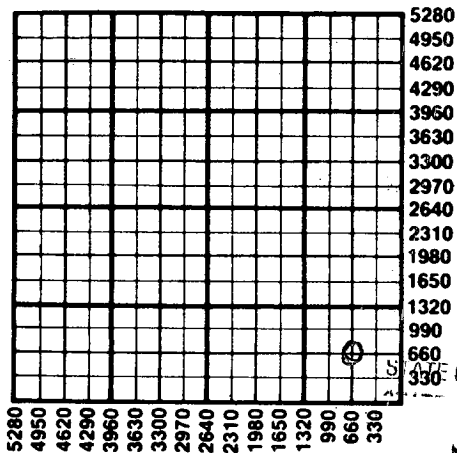

RECEIVED
STATE CORPORATION COMMISSION

JUN 17 1988
06-17-1988
CONSERVATION DIVISION
Wichita, Kansas

State Corporation Commission of Kansas
Conservation Division
200 Colorado Derby Building
Wichita, Kansas 67202
(316) 263-3238