

District # 4  
SGA?  Yes  No

# NOTICE OF INTENT TO DRILL

Must be approved by KCC five (5) days prior to commencing well

**CORRECTED**  
KCC WICHITA

40'W, 120'S

Expected Spud Date 8 23 2002  
month day year

Spot CSE Sec. 32 Twp. 10 S. R. 19  
 East  West

OPERATOR: License# 6892  
Name: Trich Production, Inc  
Address: P. O. Box 1408  
City/State/Zip: Longview, Texas 75606  
Contact Person: Ken Fletcher  
Phone: (972) 422-4335

1200 feet from (S) / (X) (circle one) Line of Section  
1360 feet from (E) / (W) (circle one) Line of Section  
is SECTION  Regular  Irregular?

CONTRACTOR: License# 30606  
Name: Murfin Drilling Company, Inc.

(Note: Locate well on the Section Plat on reverse side)  
County: Rooks  
Lease Name: Armbrister Well #: 1-32  
Field Name: Wildcat

Well Drilled For:	Well Class:	Type Equipment:
<input checked="" type="checkbox"/> Oil <input type="checkbox"/> Enh Rec <input type="checkbox"/> Infield <input checked="" type="checkbox"/> Mud Rotary	<input type="checkbox"/> Storage <input type="checkbox"/> Pool Ext. <input type="checkbox"/> Air Rotary	<input type="checkbox"/> Cable
<input type="checkbox"/> Gas <input type="checkbox"/> Disposal <input checked="" type="checkbox"/> Wildcat	<input type="checkbox"/> Other	
<input type="checkbox"/> OWWO <input type="checkbox"/> Seismic; # of Holes <input type="checkbox"/> Other		

Is this a Prorated / Spaced Field?  Yes  No  
Target Formation(s): LKC/Arbuckle  
Nearest Lease or unit boundary: 4250' 1200'  
Ground Surface Elevation: 2110 est. feet MSL  
Water well within one-quarter mile:  Yes  No  
Public water supply well within one mile:  Yes  No  
Depth to bottom of fresh water: 180'  
Depth to bottom of usable water: 760'  
Surface Pipe by Alternate: 1 X 2  
Length of Surface Pipe Planned to be set: 250'  
Length of Conductor Pipe required: NA  
Projected Total Depth: 3800'  
Formation at Total Depth: Arbuckle

If OWWO: old well information as follows:  
Operator: \_\_\_\_\_  
Well Name: \_\_\_\_\_  
Original Completion Date: \_\_\_\_\_ Original Total Depth: \_\_\_\_\_

Water Source for Drilling Operations:  
Well \_\_\_\_\_ Farm Pond \_\_\_\_\_ Other X  
DWR Permit #: \_\_\_\_\_

Directional, Deviated or Horizontal wellbore?  Yes  No  
If Yes, true vertical depth: \_\_\_\_\_  
Bottom Hole Location: \_\_\_\_\_  
KCC DKT #: \_\_\_\_\_

(Note: Apply for Permit with DWR )  
Will Cores be taken?  Yes  No  
If Yes, proposed zone: \_\_\_\_\_

\* LOC WAS 1250 fsl, 1460 FEL  
LOG IS 1200 fsl, 1360 FEL

### AFFIDAVIT

Spot Loc: WAS: 90'W 70'S CSE  
IS: 40'W, 120'S CSE

The undersigned hereby affirms that the drilling, completion and eventual plugging of this well will comply with K.S.A. 55-101, et. seq.

It is agreed that the following minimum requirements will be met:

1. Notify the appropriate district office **prior** to spudding of well;
2. A copy of the approved notice of intent to drill **shall be** posted on each drilling rig;
3. The minimum amount of surface pipe as specified below **shall be set** by circulating cement to the top; in all cases surface pipe **shall be set** through all unconsolidated materials plus a minimum of 20 feet into the underlying formation.
4. If the well is dry hole, an agreement between the operator and the district office on plug length and placement is necessary **prior to plugging**;
5. The appropriate district office will be notified before well is either plugged or production casing is cemented in;
6. If an ALTERNATE II COMPLETION, production pipe shall be cemented from below any usable water to surface within **120 days** of spud date. **In all cases, NOTIFY district office** prior to any cementing.

hereby certify that the statements made herein are true and to the best of my knowledge and belief.

Date: 8-5-2002 Signature of Operator or Agent: [Signature] Title: Agent

**For KCC Use ONLY**  
API # 15 - 163.23351.0000  
Conductor pipe required NONE feet  
Minimum surface pipe required 200 feet per Alt. (2)  
Approved by: RJP 8-8-02 / RJP 8-16-02  
This authorization expires: 2-8-03  
(This authorization void if drilling not started within 6 months of effective date.)  
Spud date: \_\_\_\_\_ Agent: \_\_\_\_\_

- Remember to:**
- File Drill Pit Application (form CDP-1) with Intent to Drill;
  - File Completion Form-ACO-1 within 120 days of spud date;
  - File acreage attribution plat according to field proration orders;
  - Notify appropriate district office 48 hours prior to workover or re-entry;
  - Submit plugging report (CP-4) after plugging is completed;
  - Obtain written approval before disposing or injecting salt water.

32 10 19w

PLAT AND CERTIFICATION OF ACREAGE ATTRIBUTABLE TO A OIL WELL

Kansas Corporation Commission, Conservation Division  
 Finney State Office Building, 130 South Market, Room 2078  
 Wichita, Kansas 67202

RECEIVED  
 AUG 15 2002  
 KCC WICHITA

API NUMBER 15- \_\_\_\_\_

LOCATION OF WELL: COUNTY Rooks

OPERATOR Trich Production, Inc.

LEASE Armbrister

1200 feet from south/north line of section

WELL NUMBER 1-32

1360 feet from east / west line of section

FIELD Wildcat

SECTION 32 TWP 10 (S) RG 19 E/W

NUMBER OF ACRES ATTRIBUTABLE TO WELL 40

IS SECTION X REGULAR or \_\_\_\_\_ IRREGULAR



QTR/QTR/QTR OF ACREAGE \_\_\_\_\_ - Approx. CSE

IF SECTION IS IRREGULAR, LOCATE WELL FROM

NEAREST CORNER BOUNDARY. (check line below)

Section corner used: NE NW SE SW

(Show the location of the well and shade attributable acreage for prorated or spaced wells).  
 (Show the footage to the nearest lease or unit boundary line; and show footage to the nearest common source supply well).

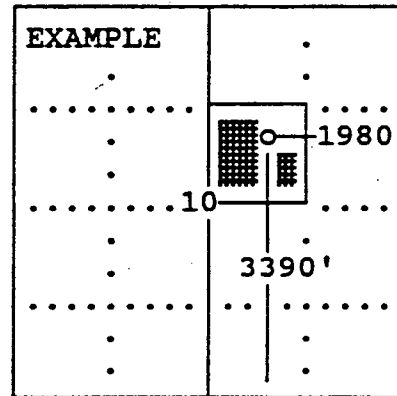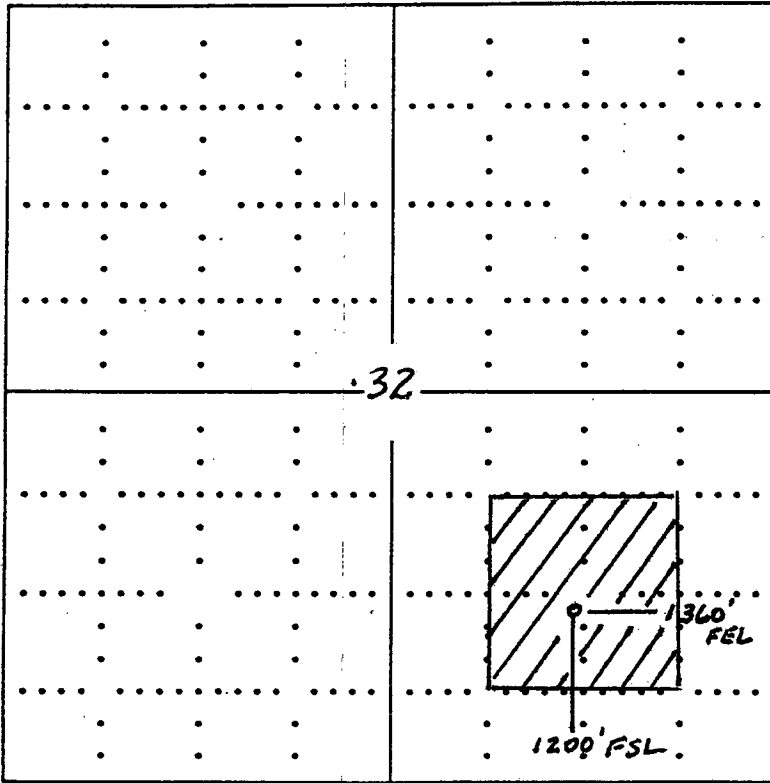

SEWARD CO.

The undersigned hereby certifies as \_\_\_\_\_ Agent \_\_\_\_\_ (title) for

\_\_\_\_\_ (Co.), a duly authorized agent, that all information shown hereon is true and correct to the best of my knowledge and belief, that all acreage claimed attributable to the well named herein is held by production from that well.

Signature Kenneth M. [Signature]

Subscribed and sworn to before me on this 13<sup>th</sup> day of August, 2002

W J Emerson  
 Notary Public

My Commission expires 10-31-05

