

CARD MUST BE TYPED

State of Kansas
NOTICE OF INTENTION TO DRILL

CARD MUST BE SIGNED

(see rules on reverse side)

Starting Date: ... FEBRUARY ... 21 ... 1985 ...
month day year

API Number 15- 163-22,634-00-00

OPERATOR: License # 5430
Name ENERGY THREE, INC.
Address P.O. BOX 1505
City/State/Zip GREAT BEND, KANSAS 67530
Contact Person CHARLES DIXON
Phone AC376-792-5968

. SE. NE. SE. Sec 33. Twp 10. S, Rge 19. East
(location) West
1650 Ft North from Southeast Corner of Section
330 Ft West from Southeast Corner of Section
(Note: Locate well on Section Plat on reverse side)

CONTRACTOR: License # 5836
Name BIG THREE DRILLING, INC.
City/State P.O. BOX 52, GORHAM, KS 67640

Nearest lease or unit boundary line 330 feet.
County ROOKS
Lease Name BLANCHETT Well# 1

Well Drilled For: Well Class: Type Equipment:
 Oil Swd Infield Mud Rotary
 Gas Inj Pool Ext. Air Rotary
 OWWO Expl Wildcat Cable

Domestic well within 330 feet: yes no
Municipal well within one mile: yes no

If OWWO: old well info as follows:
Operator
Well Name
Comp Date Old Total Depth
Projected Total Depth 3800 feet
Projected Formation at TD ARBUCKLE
Expected Producing Formations ARBUCKLE

Depth to Bottom of fresh water 110 feet
Lowest usable water formation DAKOTA
Depth to Bottom of usable water 900 feet
Surface pipe by Alternate: 1 2
Surface pipe to be set 240 feet
Conductor pipe if any required
Ground surface elevation feet MSL
This Authorization Expires 2-11-85
Approved By 2-11-85 R

I certify that we will comply with K.S.A. 55-101, et seq., plus eventually plugging hole to K.C.C. specifications.


Date 2-8-85 Signature of Operator or Agent Charles Dixon Title EXECUTIVE VICE-PRESIDENT

MICHAEL MOHE 2-8-85
Form C-1 4/84

Must be filed with the K.C.C. five (5) days prior to commencing well
This card void if drilling not started within six (6) months of date received by K.C.C.

RECEIVED
STATE CORPORATION COMMISSION
02-11-1985
FEB 11 1985

**A Regular Section of Land
1 Mile = 5,280 Ft.**

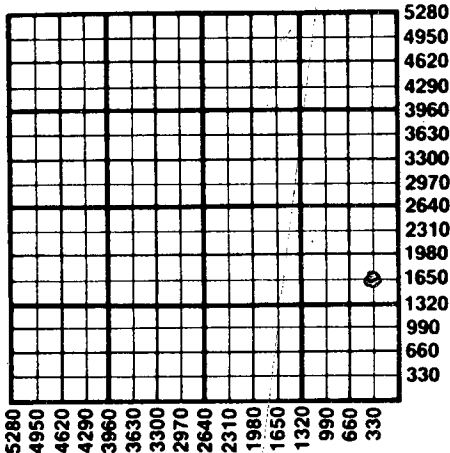

Important procedures to follow:
CONSERVATION DIVISION
Wichita, Kansas

1. Notify District office before setting surface casing.
2. Set surface casing by circulating cement to the top.
3. File completion forms ACO-1 with K.C.C. within 90 days of well completion, following instructions on ACO-1, side 1, and including copies of wireline logs.
4. Notify District office 48 hours prior to old well workover or re-entry.
5. Prior to plugging, prepare a plugging plan, then obtain agreement from the appropriate district office for an approved plugging plan.
6. Submit plugging report (CP-4) to K.C.C. after plugging is completed.
7. Obtain an approved injection docket number before disposing of salt water.
8. Notify K.C.C. within 10 days when injection commences or terminates.
9. If an alternate 2 completion, cement in the production pipe from below any usable water to surface within 120 days of spud date.

**State Corporation Commission of Kansas
Conservation Division
200 Colorado Derby Building
Wichita, Kansas 67202
(316) 263-3238**