

Must be approved by the K.C.C. five (5) days prior to commencing well

Expected Spud Date 10/03/89
month day year

APX SW SW 01. 10 21 — East
SE Sec Twp S, Rg West

OPERATOR: License # 3007
Name: WESTERN KANSAS EXPLORATION
Address: P.O. BOX 126
City/State/Zip: HAYS KS 67601
Contact Person: STAN YOUNGER
Phone: (913) 628-2296

330 feet from South line of Section
4920 feet from East line of Section
(Note: Locate well on Section Plat Below)

CONTRACTOR: License #: 4083
Name: WESTERN KANSAS DRILLING

County: GRAHAM
Lease Name: VIRGINIA MILLER Well #: #1
Field Name: COOPER

Well Drilled For: Well Class: Type Equipment:
XX. Oil ... Inj XX. Infield XX. Mud Rotary
... Gas ... Storage ... Pool Ext. ... Air Rotary
... OAWO ... Disposal ... Wildcat ... Cable
... Seismic; ... # of Holes

Is this a Prorated Field? yes XX no
Target Formation(s): ARBUCKLE
Nearest lease or unit boundary: 330
Ground Surface Elevation: N/A feet MSL
Domestic well within 330 feet: yes XX no
Municipal well within one mile: yes XX no
Depth to bottom of fresh water: 180
Depth to bottom of usable water: 1200 1100'
Surface Pipe by Alternate: 1 XX 2
Length of Surface Pipe Planned to be set: 200
Length of Conductor pipe required: *****
Projected Total Depth: 3900
Formation at Total Depth: ARBUCKLE
Water Source for Drilling Operations:
... well ... farm pond XX other

If OAWO: old well information as follows:
Operator:
Well Name:
Comp. Date: Old Total Depth

Directional, Deviated or Horizontal wellbore? yes .XX no
If yes, total depth location:

DWR Permit #:
Will Cores Be Taken? yes XX no
If yes, proposed zone:

AFFIDAVIT


The undersigned hereby affirms that the drilling, completion and eventual plugging of this well will comply with K.S.A. 55-101, et. seq.

It is agreed that the following minimum requirements will be met:

1. The appropriate district office shall be notified before setting surface pipe;
2. The minimum amount of surface pipe as specified above shall be set by circulating cement to the top; in all cases surface pipe shall be set through all unconsolidated materials plus a minimum of 20 feet into the underlying formation;
3. If the well is dry, a plugging proposal shall be submitted to the district office. An agreement between the operator and the district office on plug length and placement is necessary prior to plugging;
4. The appropriate district office will be notified before well is either plugged or production casing is cemented in;
5. If an Alternate II completion, production pipe shall be cemented from below any usable water to surface within 120 days of spud date. In all cases, notify district office prior to any cementing.

I hereby certify that the statements made herein are true and to the best of my knowledge and belief.

Date: 10/04/89 Signature of Operator or Agent: [Signature] Title: AGENT

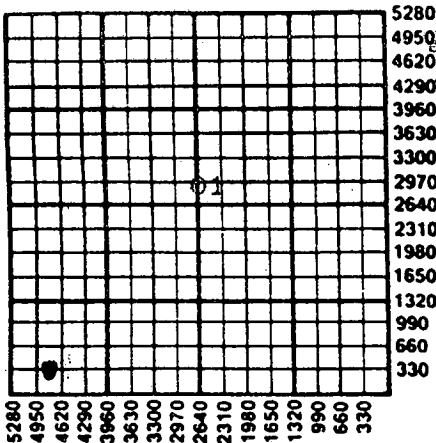

RECEIVED
STATE CORPORATION COMMISSION
OCT 4 1989
10-04-1989
CONSERVATION DIVISION
Wichita, Kansas

SEARCH INC.
FOR KCC USE: ✓ D
API # 15-065-22,540-00-00
Conductor pipe required NONE feet
Minimum surface pipe required 200 feet per Alt. X②
Approved by: DPW 10-04-89
EFFECTIVE DATE: 10-09-89
This authorization expires: 4-7-90
(This authorization void if drilling not started within 6 months of effective date.)
Spud date: _____ Agent: _____

REMEMBER TO:

- File Drill Pit Application (form CDP-1) with Intent to Drill;
- File Completion Form ACO-1 within 120 days of spud date;
- File acreage attribution plat according to field proration orders;
- Notify appropriate district office 48 hours prior to workover or re-entry;
- Submit plugging report (CP-4) after plugging is completed;
- Obtain written approval before disposing or injecting salt water.