

CARD MUST BE TYPED

NOTICE OF INTENTION TO DRILL

State of Kansas
(see rules on reverse side)

CARD MUST BE SIGNED

Starting Date: 12 10 84
month day year

API Number 15- 179-20,777-00-00

OPERATOR: License # 4022
Name Vincent J. Duncan
Address 600 17th St., Suite 2300 South
City/State/Zip Denver, CO 80202
Contact Person Paul Cella
Phone 303-623-4158

C. SW. SE Sec. 8. Twp 9. S, Rge 28. East West
(location)

660 Ft North from Southeast Corner of Section
1980 Ft West from Southeast Corner of Section
(Note: Locate well on Section Plat on reverse side)

CONTRACTOR: License # 6033
Name Murfin Drilling Company
City/State Wichita, KS 67202

Nearest lease or unit boundary line 660 feet.
County Sheridan
Lease Name Mosier Well# 8-1

Well Drilled For: Well Class: Type Equipment:
 Oil Swd Infield Mud Rotary
 Gas Inj Pool Ext. Air Rotary
 OWWO Expl Wildcat Cable

Domestic well within 330 feet: yes no
Municipal well within one mile: yes no

If OWWO: old well info as follows:

Operator
Well Name
Comp Date Old Total Depth
Projected Total Depth 4200 feet
Projected Formation at TD Miss.
Expected Producing Formations LKC

Depth to Bottom of fresh water 200 feet
Lowest usable water formation Dakota
Depth to Bottom of usable water 1400/500 feet
Surface pipe by Alternate: 1 2
Surface pipe to be set 250 feet
Conductor pipe if any required N/A feet
Ground surface elevation feet MSL
This Authorization Expires 5-14-85
Approved By 11-14-84 [Signature]

I certify that we will comply with K.S.A. 55-101, et seq., plus eventually plugging hole to K.C.C. specifications.

Date 11-14-84 Signature of Operator or Agent

[Signature] Title Ass't. Drilling Manager
Jack E. Goss, Agent for Operator

MHC/KONE 11/14/84

RECEIVED
STATE CORPORATION COMMISSION

Must be filed with the K.C.C. five (5) days prior to commencing well
This card void if drilling not started within six (6) months of date received by K.C.C.


NOV 14 1984
11-14-1984

CONSERVATION DIVISION

Wichita, Kansas

A Regular Section of Land

1 Mile = 5,280 Ft.

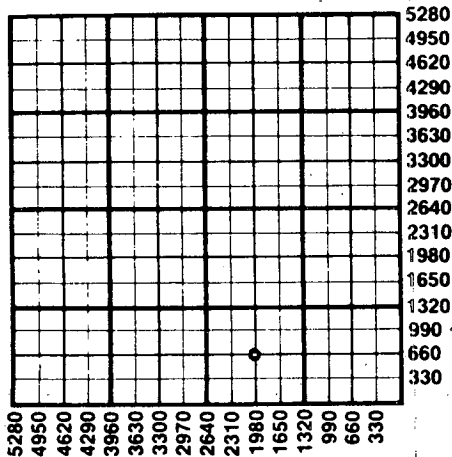

R

Important procedures to follow:

1. Notify District office before setting surface casing.
2. Set surface casing by circulating cement to the top.
3. File completion forms ACO-1 with K.C.C. within 90 days of well completion, following instructions on ACO-1, side 1, and including copies of wireline logs.
4. Notify District office 48 hours prior to old well workover or re-entry.
5. Prior to plugging, prepare a plugging plan, then obtain agreement from the appropriate district office for an approved plugging plan.
6. Submit plugging report (CP-4) to K.C.C. after plugging is completed.
7. Obtain an approved injection docket number before disposing of salt water.
8. Notify K.C.C. within 10 days when injection commences or terminates.
9. If an alternate 2 completion, cement in the production pipe from below any usable water to surface within 120 days of spud date.

State Corporation Commission of Kansas
Conservation Division
200 Colorado Derby Building
Wichita, Kansas 67202
(316) 263-3238