

CARD MUST BE TYPED

State of Kansas
NOTICE OF INTENTION TO DRILL

CARD MUST BE SIGNED

(see rules on reverse side)

Starting Date: 2 2 85
month day year

API Number 15- 163-22, 620-00-00

OPERATOR: License # 5171
Name TXO Production Corp.
Address 200 W. Douglas, Suite 300
City/State/Zip Wichita, KS 67202
Contact Person Gary Wurdeman
Phone 316-265-9441

N/2 SE. Sec 10. Twp 10. S, Rge 20...
(location) East West

.....1980..... Ft North from Southeast Corner of Section
.....1320..... Ft West from Southeast Corner of Section
(Note: Locate well on Section Plat on reverse side)

CONTRACTOR: License # 6033
Name Murfin Drilling Company
City/State Wichita, KS

Nearest lease or unit boundary line 660 feet.
County Rooks
Lease Name HINKHOUSE "B" Well# 1

Well Drilled For: Well Class: Type Equipment:
 Oil Swd Infield Mud Rotary
 Gas Inj Pool Ext. Air Rotary
 OWWO Expl Wildcat Cable

Domestic well within 330 feet: yes no
Municipal well within one mile: yes no

If OWWO: old well info as follows:

Operator
Well Name
Comp Date Old Total Depth
Projected Total Depth ... 3850 feet
Projected Formation at TD ... Arbuckle
Expected Producing Formations ... Arbuckle

Depth to Bottom of fresh water ... 100 feet
Lowest usable water formation ... Dakota
Depth to Bottom of usable water ... ~~800~~ 950 feet
Surface pipe by Alternate: 1 2
Surface pipe to be set ... 250 feet
Conductor pipe if any required ... 0 feet
Ground surface elevation ... TBD feet MSL
This Authorization Expires 7-28-85
Approved By RCH/Kec 1-18-85

I certify that we will comply with K.S.A. 55-101, et seq., plus eventually plugging hole to K.C.C. specifications.

Date 1-16-85 Signature of Operator or Agent Gary Wurdeman Title Drilling & Production Mgr.


Form C-1 4/84

MHC/JOHE 1-18-85

Must be filed with the K.C.C. five (5) days prior to commencing well
 This card void if drilling not started within six (6) months of date received by K.C.C.
 CONSERVATION DIVISION
 WICHITA, KANSAS

JAN 18 1985

STATE CORPORATION COMMISSION
 A Regular Section of Land
 1 Mile = 3,280 Ft.
 01-18-1985

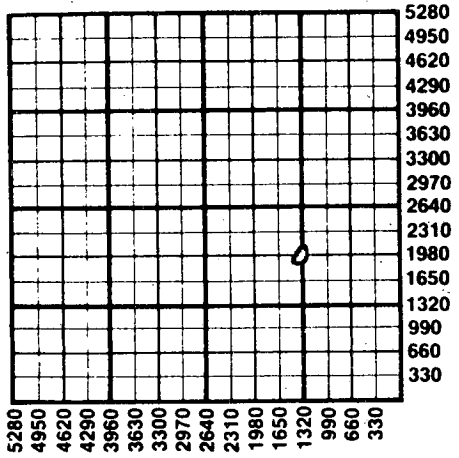

Important procedures to follow :

1. Notify District office before setting surface casing.
2. Set surface casing by circulating cement to the top.
3. File completion forms ACO-1 with K.C.C. within 90 days of well completion, following instructions on ACO-1, side 1, and including copies of wireline logs.
4. Notify District office 48 hours prior to old well workover or re-entry.
5. Prior to plugging, prepare a plugging plan, then obtain agreement from the appropriate district office for an approved plugging plan.
6. Submit plugging report (CP-4) to K.C.C. after plugging is completed.
7. Obtain an approved injection docket number before disposing of salt water.
8. Notify K.C.C. within 10 days when injection commences or terminates.
9. If an alternate 2 completion, cement in the production pipe from below any usable water to surface within 120 days of spud date.

State Corporation Commission of Kansas
 Conservation Division
 200 Colorado Derby Building
 Wichita, Kansas 67202
 (316) 263-3238

CARD MUST BE TYPED

State of Kansas
NOTICE OF INTENTION TO DRILL
(see rules on reverse side)

CARD MUST BE SIGNED

Starting Date: 2 month 2 day 85 year

API Number: 15-163-22, 620-00-00

OPERATOR: License # 5171
Name TXO Production Corp.
Address 200 W. Douglas, Suite 300
City/State/Zip Wichita, KS 67202
Contact Person Gary Wurdeman
Phone 316-265-9441

N/2 SE Sec 10 Twp 10 S Rgn 20 East West
(location)

1980 Ft North from Southeast Corner of Section
1320 Ft West from Southeast Corner of Section
(Note: Locate well on Section Plat on reverse side)

CONTRACTOR: License # 6033
Name Murfin Drilling Company
City/State Wichita, KS

Nearest lease or unit boundary line 660 feet

County Rooks

Lease Name HINKHOUSE "B" Well# 1

Domestic well within 330 feet: yes no

Municipal well within one mile: yes no

Well Drilled For: Well Class: Type Equipment:
 Oil Swd Infield Mud Rotary
 Gas Inj Pool Ext. Air Rotary
 OWWO Expl Wildcat Cable

Depth to Bottom of fresh water 100 feet

Lowest usable water formation Dakota

Depth to Bottom of usable water 800-950 feet

Surface pipe by Alternate: 1 2

Surface pipe to be set 250 feet

Conductor pipe if any required 0 feet

Ground surface elevation TBD feet MSI

This Authorization Expires 7-18-85

Approved By R.H./K.C. 1-18-85

If OWWO: old well info as follows:
Operator
Well Name
Comp Date Old Total Depth
Projected Total Depth 3850 feet
Projected Formation at TD Arbuckle
Expected Producing Formations Arbuckle

certify that we will comply with K.S.A. 55-101, et seq., plus eventually plugging hole to K.C.C. specifications.

1-16-85 Signature of Operator or Agent *Jay E. Wurdeman* Title Drilling & Production Mgr.

Form C-1 4/84

MHC/KOHE 1-18-85

Rec'd
01-18-1985

RECEIVED
STATE CORPORATION COMMISSION

MAR 04 1985

CONSERVATION DIVISION
Wichita, Kansas