

CARD MUST BE TYPED

State of Kansas  
**NOTICE OF INTENTION TO DRILL**  
(see rules on reverse side)

CARD MUST BE SIGNED

Starting Date: .....10.....7.....84.....  
month day year

API Number 15- 163-22,498-0000

OPERATOR: License # .....5422.....

.....C. NW SW NE. Sec. 24 Twp. 8. S, Rge 18.  East  
(location)  West

Name .....Abercrombie Drilling, Inc.....

Address .....801 Union Center.....

City/State/Zip .....Wichita, KS...67202.....

Contact Person ..Jack L. Partridge.....

Phone .....316-262-1841.....

.....3630.. Ft North from Southeast Corner of Section  
.....2310... Ft West from Southeast Corner of Section  
(Note: Locate well on Section Plat on reverse side)

CONTRACTOR: License # .....5422.....

Nearest lease or unit boundary line .....1650..... feet.  
County ....Rooks.....

Name .....Abercrombie Drilling, Inc.....

Lease Name Thomas..... Well# .....3.....

City/State .....Wichita, KS...67202.....

Domestic well within 330 feet :  yes  no

Well Drilled For: Well Class: Type Equipment:

Municipal well within one mile :  yes  no

Oil  Swd  Infield  Mud Rotary

Depth to Bottom of fresh water .....100..... feet

Gas  Inj  Pool Ext.  Air Rotary

Lowest usable water formation .....Dakota.....

OWWO  Expl  Wildcat  Cable

Depth to Bottom of usable water .....850..... feet

If OWWO: old well info as follows:

Surface pipe by Alternate : 1  2

Operator .....

Surface pipe to be set .....200..... feet

Well Name .....

Conductor pipe if any required None..... feet

Comp Date ..... Old Total Depth .....

Projected Total Depth .....3500..... feet

Ground surface elevation .....1975..... feet MSL

Projected Formation at TD .....Arbuckle.....

This Authorization Expires .....3-25-85.....

Expected Producing Formations .....Arbuckle.....

Approved By .....9-25-84..... k

I certify that we will comply with K.S.A. 55-101, et seq., plus eventually plugging hole to K.C.C. specifications.

Date ..9-25-84..... Signature of Operator or Agent

*Jack L. Partridge*  
Jack L. Partridge


Title ..V.P. Abercrombie Drilling

WICHITA, KANSAS  
CONSERVATION DIVISION

Must be filed with the K.C.C. five (5) days prior to commencing well  
This card void if drilling not started within six (6) months of date received by K.C.C.

SEP 25 1984  
507 251984  
STATE CORP. COM. OF KANSAS

A Regular Section of Land  
1 Mile = 5,280 Ft.

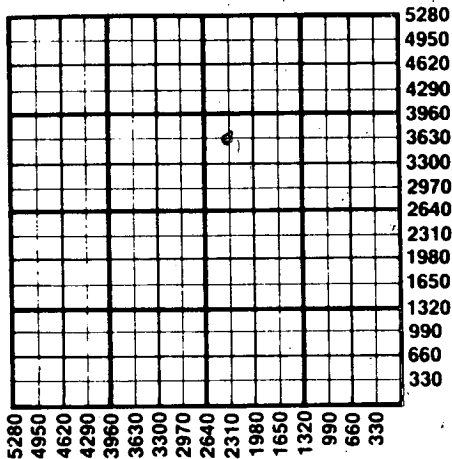

**Important procedures to follow :**

1. Notify District office before setting surface casing.
2. Set surface casing by circulating cement to the top.
3. File completion forms ACO-1 with K.C.C. within 90 days of well completion, following instructions on ACO-1, side 1, and including copies of wireline logs.
4. Notify District office 48 hours prior to old well workover or re-entry.
5. Prior to plugging, prepare a plugging plan, then obtain agreement from the appropriate district office for an approved plugging plan.
6. Submit plugging report (CP-4) to K.C.C. after plugging is completed.
7. Obtain an approved injection docket number before disposing of salt water.
8. Notify K.C.C. within 10 days when injection commences or terminates.
9. If an alternate 2 completion, cement in the production pipe from below any usable water to surface within 120 days of spud date.

State Corporation Commission of Kansas  
Conservation Division  
200 Colorado Derby Building  
Wichita, Kansas 67202  
(316) 263-3238