

CARD MUST BE TYPED

State of Kansas
NOTICE OF INTENTION TO DRILL
(see rules on reverse side)

CARD MUST BE SIGNED

Starting Date: 11 23 84
month day year

OPERATOR: License # 5313
Name F. & M. OIL CO., INC.
Address 422 Union Center
City/State/Zip Wichita, Kansas 67202
Contact Person E. A. Falkowski
Phone (316) 262-2636

CONTRACTOR: License # 5103
Name Union Drilling Co., Inc.
City/State Wichita, Kansas 67202

Well Drilled For: Well Class: Type Equipment:
 Oil Swd Infield Mud Rotary
 Gas Inj Pool Ext. Air Rotary
 OWWO Expl Wildcat Cable

If OWWO: old well info as follows:

Operator N/A
Well Name _____
Comp Date _____ Old Total Depth _____

Projected Total Depth 3400 feet
Projected Formation at TD Arbuckle
Expected/Producing Formations Lns/KC & Arbuckle

I certify that we will comply with K.S.A. 55-101, et seq., plus eventually plugging hole to K.C.C. specifications.

Date 11-20-84 Signature of Operator or Agent *E. A. Falkowski* Title President

API Number 15- 163-22,569-0000
~~CNE~~ NE NE Sec 27 Twp 8 S, Rge 18W East West
(location)

4950 Ft North from Southeast Corner of Section
660 Ft West from Southeast Corner of Section
(Note: Locate well on Section Plat on reverse side)

Nearest lease or unit boundary line 330 feet.
County Rooks
Lease Name Garey "A" Well# 1
Domestic well within 330 feet: yes no
Municipal well within one mile: yes no

1880 Depth to Bottom of fresh water 100 feet
Lowest usable water formation Dakota
Depth to Bottom of usable water 800 feet
Surface pipe by Alternate: 1 2
Surface pipe to be set 260 feet
Conductor pipe if any required *1980* feet
Ground surface elevation _____ feet MSL.
This Authorization Expires 5-20-85
Approved By 11-20-84 *E. A. Falkowski*

President

W. H. C. / U. O. H. E. 11/20/84

RECEIVED Must be filed with the K.C.C. five (5) days prior to commencing well
STATE CORPORATION COMMISSION drilling not started within six (6) months of date received by K.C.C.

NOV 20 1984


11-20-84

CONSERVATION DIVISION
WICHITA, KANSAS

A Regular Section of Land
1 Mile = 6,280 Ft.

Important procedures to follow :

1. Notify District office before setting surface casing.
2. Set surface casing by circulating cement to the top.
3. File completion forms ACO-1 with K.C.C. within 90 days of well completion, following instructions on ACO-1, side 1, and including copies of wireline logs.
4. Notify District office 48 hours prior to old well workover or re-entry.
5. Prior to plugging, prepare a plugging plan, then obtain agreement from the appropriate district office for an approved plugging plan.
6. Submit plugging report (CP-4) to K.C.C. after plugging is completed.
7. Obtain an approved injection docket number before disposing of salt water.
8. Notify K.C.C. within 10 days when injection commences or terminates.
9. If an alternate 2 completion, cement in the production pipe from below any usable water to surface within 120 days of spud date.

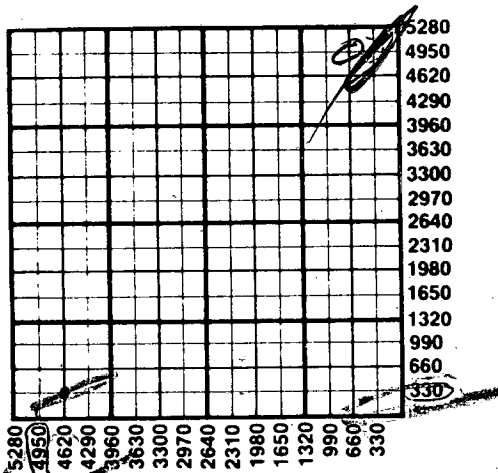

State Corporation Commission of Kansas
Conservation Division
200 Colorado Derby Building
Wichita, Kansas 67202
(316) 263-3238