

CARD MUST BE TYPED

State of Kansas
NOTICE OF INTENTION TO DRILL
(see rules on reverse side)

CARD MUST BE SIGNED

Starting Date: November 11, 1984
month day year

API Number 15- 065-22,091-00-0

OPERATOR: License # 5293
Name Helmerich & Payne, Inc.
Address P.O. Box 558
City/State/Zip Garden City, KS 67846
Contact Person Millard L. Lindsay
Phone 316-276-3693

..... East
..SE. SE.. SW Sec. 10. Twp. 8. S, Rge. 25. West
(location)

..... 360. Ft North from Southeast Corner of Section
..... 2970. Ft West from Southeast Corner of Section
(Note: Locate well on Section Plat on reverse side)

CONTRACTOR: License # 5665
Name Pioneer Drilling
City/State Plainville, KS 67663

Nearest lease or unit boundary line 330 feet.
County Graham

Lease Name Walts Well# 6

Domestic well within 330 feet : yes no
Municipal well within one mile : yes no

Well Drilled For: Well Class: Type Equipment:
 Oil Swd Infield Mud Rotary
 Gas Inj Pool Ext. Air Rotary
 OWWO Expl Wildcat Cable

Depth to Bottom of fresh water 120 feet
Lowest usable water formation Dakota
Depth to Bottom of usable water 1250-550 feet
Surface pipe by Alternate : 1 2

Surface pipe to be set 250 feet
Conductor pipe if any required None feet

Ground surface elevation 2327 feet MSL
This Authorization Expires 4-18-85

Approved By 10-15-84 [Signature]

If OWWO: old well info as follows:

Operator
Well Name
Comp Date Old Total Depth
Projected Total Depth 3900 feet
Projected Formation at TD L-KC
Expected Producing Formations L-KC

I certify that we will comply with K.S.A. 55-101, et seq., plus eventually plugging hole to K.C.C. specifications.


Date ... 10-17-84 ... Signature of Operator or Agent [Signature] Title ... Dist. Prod. Manager. .

MHC/KOHE 10/18/84
Form C-1 4/84

Must be filed with the K.C.C. five (5) days prior to commencing well
 This card void if drilling not started within six (6) months of date received by K.C.C.

Important procedures to follow:

A Regular Section of Land
1 Mile = 5,280 Ft.

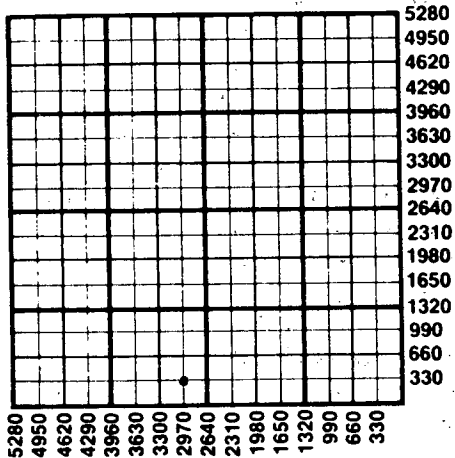

1. Notify District office before setting surface casing.
2. Set surface casing by circulating cement to the top.
3. File completion forms ACO-1 with K.C.C. within 90 days of well completion, following instructions on ACO-1, side 1, and including copies of wireline logs.
4. Notify District office 48 hours prior to old well workover or re-entry.
5. Prior to plugging, prepare a plugging plan, then obtain agreement from the appropriate district office for an approved plugging plan.
6. Submit plugging report (CP-4) to K.C.C. after plugging is completed.
7. Obtain an approved injection docket number before disposing of salt water.
8. Notify K.C.C. within 10 days when injection commences or terminates.
9. If an alternate 2 completion, cement in the production pipe from below any usable water to surface within 120 days of spud date.

10/18/84

RECEIVED
 STATE CORPORATION COMMISSION

OCT 18 1984

CONSERVATION DIVISION
 WICHITA, KANSAS

State Corporation Commission of Kansas
 Conservation Division
 200 Colorado Derby Building
 Wichita, Kansas 67202
 (316) 263-3238