

NOTICE OF INTENTION TO DRILL

(see rules on reverse side)

Starting Date 12-1-87 month day year

API Number 15-163-22,969-00-00 D+A

OPERATOR: License # E6725 Name Eric Waddell Company Address Box 349 City/State/Zip Natoma, KS 67651 Contact Person Eric F. Waddell Phone 913-885-4497

SW SW SE Sec. 12 Twp. 8 S, Rg. 20 West 330 Ft. from South Line of Section 2310 Ft. from East Line of Section

(Note: Locate well on Section Plat on reverse side)

CONTRACTOR: License # Name City/State

Nearest lease or unit boundary line 330 feet County ROCKS Lease Name Thyfault Well # 1

Ground surface elevation 1975' TOPO feet MSL

Well Drilled For: Well Class: Type Equipment: Oil SWD Infield Mud Rotary Gas Inj Pool Ext Air Rotary OWWO Expl Wildcat Cable

Domestic well within 330 feet: yes no Municipal well within one mile: yes no

Depth to bottom of fresh water ~100

Depth to bottom of usable water 800

Surface pipe by Alternate: 1 2 X

Surface pipe planned to be set 230

Conductor pipe required

Projected Total Depth 3600 feet

Formation Arbuckle

If OWWO: old well info as follows: Operator Well Name Comp Date Old Total Depth

I certify that well will comply with K.S.A. 55-101, et seq., plus eventually plugging hole to KCC specifications. Date 11/23/87 Signature of Operator or Agent Tracy L. Cooley Title geologist

For KCC Use: Conductor Pipe Required feet; Minimum Surface Pipe Required 200 feet per Alt. 2

This Authorization Expires 5-25-88 Approved By 8/11-25-87


EFFECTIVE DATE: 11-30-87

Must be filed with the K.C.C. five (5) days prior to commencing well
This card void if drilling not started within six (6) months of date received by K.C.C.

Important procedures to follow:

1. Notify District office before setting surface casing.
2. Set surface casing by circulating cement to the top.
3. File completion forms ACO-1 with K.C.C. within 90 days of well completion, following instructions on ACO-1, side 1, and including copies of wireline logs.
4. Notify District office 48 hours prior to old well workover or re-entry.
5. Prior to filing Intent, prepare a proposed plugging plan in case well is D & A, then obtain approval of plan when calling district office prior to setting surface pipe.
6. Submit plugging report (CP-4) to K.C.C. after plugging is completed.
7. Obtain an approved injection docket number before disposing of salt water.
8. Notify K.C.C. within 10 days when injection commences or terminates.
9. If an alternate 2 completion, cement in the production pipe from below any usable water to surface within 120 days of spud date.

A Regular Section of Land 1 Mile = 5,280 Ft.

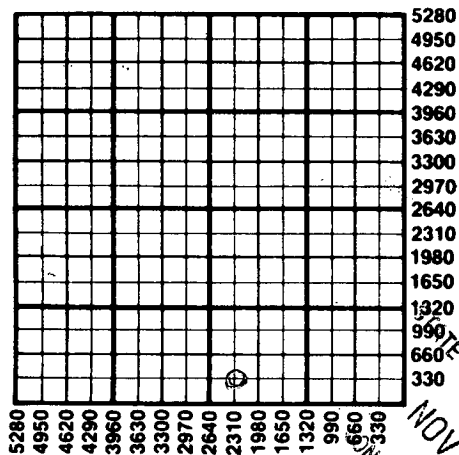

RECEIVED
NOV 25 1987
STATE CORPORATION COMMISSION
CONSERVATION DIVISION
Wichita, Kansas

11-25-87

State Corporation Commission of Kansas
Conservation Division
200 Colorado Derby Building
Wichita, Kansas 67202
(316) 263-3238