

CARD MUST BE TYPED

State of Kansas
NOTICE OF INTENTION TO DRILL

CARD MUST BE SIGNED

(see rules on reverse side)

Starting Date: October 6 1984
month day year 1120

API Number 15-065-22,082-0000

OPERATOR: License # 5238
Name Petroleum, Inc.
Address 300 W. Douglas, Suite 800
City/State/Zip Wichita, Ks. 67202
Contact Person Monte Chadd
Phone 316-793-8471

NW SE SW Sec 3 Twp 8 S, Rge 22
(location) East West

CONTRACTOR: License # 5476
Name DNB Drilling, Inc.
City/State 535 N. Oliver, Wichita, Ks. 67208

990 Ft North from Southeast Corner of Section
3630 Ft West from Southeast Corner of Section
(Note: Locate well on Section Plat on reverse side)

Well Drilled For: Well Class: Type Equipment:
 Oil Swd Infield Mud Rotary
 Gas Inj Pool Ext. Air Rotary
 OWWO Expl Wildcat Cable

Nearest lease or unit boundary line 330 feet.
County Graham
Lease Name Jones 'HJ' Well# 1

Domestic well within 330 feet: yes no
Municipal well within one mile: yes no

If OWWO: old well info as follows:
Operator
Well Name
Comp Date Old Total Depth
Projected Total Depth 3850 feet
Projected Formation at TD Arbuckle
Expected Producing Formations

Depth to Bottom of fresh water 300 feet
Lowest usable water formation Dakota
Depth to Bottom of usable water 1000 feet
Surface pipe by Alternate: 1 2
Surface pipe to be set 350 feet
Conductor pipe if any required - feet
Ground surface elevation - feet MSI
This Authorization Expires 4-5-85
Approved By 10-5-84 RC

I certify that we will comply with K.S.A. 55-101, et seq., plus eventually plugging hole to K.C.C. specifications.

Date 10-5-84 Signature of Operator or Agent

James D. Wheeler Title District Landman
MHC/KOHE 10/5/84 Form C-1 4/84

RECEIVED

Must be filed with the K.C.C. five (5) days prior to commencing well
This card void if drilling not started within six (6) months of date received by K.C.C.

MISSION

OCT 5 1984


10-5-84

CONSERVATION DIVISION

A Regular Section of Land

Wichita, Kansas

1 Mile = 5,280 Ft.

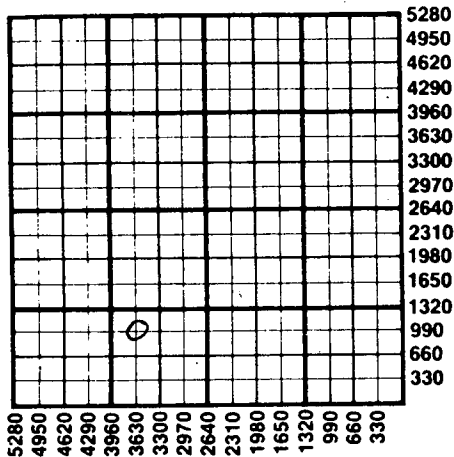

Important procedures to follow :

1. Notify District office before setting surface casing.
2. Set surface casing by circulating cement to the top.
3. File completion forms ACO-1 with K.C.C. within 90 days of well completion, following instructions on ACO-1, side 1, and including copies of wireline logs.
4. Notify District office 48 hours prior to old well workover or re-entry.
5. Prior to plugging, prepare a plugging plan, then obtain agreement from the appropriate district office for an approved plugging plan.
6. Submit plugging report (CP-4) to K.C.C. after plugging is completed.
7. Obtain an approved injection docket number before disposing of salt water.
8. Notify K.C.C. within 10 days when injection commences or terminates.
9. If an alternate 2 completion, cement in the production pipe from below any usable water to surface within 120 days of spud date.

State Corporation Commission of Kansas
 Conservation Division
 200 Colorado Derby Building
 Wichita, Kansas 67202
 (316) 263-3238