

CARD MUST BE TYPED

State of Kansas
NOTICE OF INTENTION TO DRILL

CARD MUST BE SIGNED

(see rules on reverse side)

Starting Date: 7/8/85
month day year

API Number 15- 065-22,210-00-00

OPERATOR: License # 9449
Name Great Eastern Energy & Devel. Corp.
Address 5660 S. Syracuse Circle, Ste. 220
City/State/Zip Englewood, CO 80111
Contact Person John W. Smith
Phone 303-773-6016

NE NE SW .. Sec 24 .. Twp . 8 . S, Rge . 22 .
(location) East West

..... 2310 Ft North from Southeast Corner of Section
..... 2970 Ft West from Southeast Corner of Section
(Note: Locate well on Section Plat on reverse side)

CONTRACTOR: License # 8301
Name Stoepelwerth Drilling, Inc.
City/State Mc Cook, NE 69001

Nearest lease or unit boundary line 330 feet.
County Graham
Lease Name Gosselin Well# 1

Well Drilled For: Well Class: Type Equipment:
 Oil Swd Infield Mud Rotary
 Gas Inj Pool Ext. Air Rotary
 OWWO Expl Wildcat Cable

Domestic well within 330 feet : yes no
Municipal well within one mile : yes no

If OWWO: old well info as follows:
Operator
Well Name
Comp Date Old Total Depth
Projected Total Depth 3725 feet
Projected Formation at TD Arbuckle
Expected Producing Formations

Depth to Bottom of fresh water 125 feet
Lowest usable water formation Dakota
Depth to Bottom of usable water 1200 feet
Surface pipe by Alternate : 1 2
Surface pipe to be set 250 feet
Conductor pipe if any required none feet
Ground surface elevation 2123 feet MSL
This Authorization Expires 12-27-85
Approved By 6-27-85
[Signature]

I certify that we will comply with K.S.A. 55-101, et seq., plus eventually plugging hole to K.C.C. specifications.

Date 6/27/85 Signature of Operator or Agent *[Signature]* Title

[Signature]
As Agent


Must be filed with the K.C.C. five (5) days prior to commencing well
This card void if drilling not started within six (6) months of date received by K.C.C.

RECEIVED
STATE CORPORATION COMMISSION

06-27-1985
JUN 27 1985

A Regular Section of Land
1 Mile = 5,280 Ft.

CONSERVATION DIVISION
Wichita, Kansas

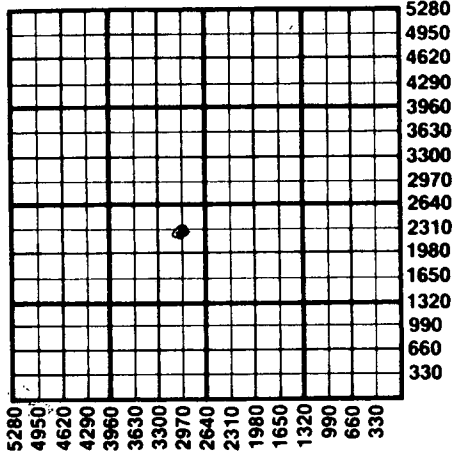

Important procedures to follow :

1. Notify District office before setting surface casing.
2. Set surface casing by circulating cement to the top.
3. File completion forms ACO-1 with K.C.C. within 90 days of well completion, following instructions on ACO-1, side 1, and including copies of wireline logs.
4. Notify District office 48 hours prior to old well workover or re-entry.
5. Prior to plugging, prepare a plugging plan, then obtain agreement from the appropriate district office for an approved plugging plan.
6. Submit plugging report (CP-4) to K.C.C. after plugging is completed.
7. Obtain an approved injection docket number before disposing of salt water.
8. Notify K.C.C. within 10 days when injection commences or terminates.
9. If an alternate 2 completion, cement in the production pipe from below any usable water to surface within 120 days of spud date.

State Corporation Commission of Kansas
Conservation Division
200 Colorado Derby Building
Wichita, Kansas 67202
(316) 263-3238