

EFFECTIVE DATE: 6-11-95

State of Kansas

DISTRICT # 4

NOTICE OF INTENTION TO DRILL

SGA? Yes.....No

Must be approved by the K.C.C. five (5) days prior to commencing well.

Expected Spud Date 6 9 95
month day year

Spot NW SW SW Sec 19 Twp 8 S, Rg 24 East West

OPERATOR: License # 3736
Name: RLT Investment
Address: Box 63
City/State/Zip: Morland, KS 67650
Contact Person: Leon Pfeifer
Phone: 913-627-5711

990 feet from South West line of Section
330 feet from East West line of Section
IS SECTION X REGULAR IRREGULAR?

(NOTE: Locate well on the Section Plat on Reverse Side)
County: Graham
Lease Name: Keith Well #: #1-19

CONTRACTOR: License #: 31664
Name: Northwest Well Service

Field Name: _____
Is this a Prorated/Spaced Field? ... yes X no

Well Drilled For: Well Class: Type Equipment:
... Oil ... Enh Rec XX Infield ... Mud Rotary
... Gas ... Storage ... Pool Ext. ... Air Rotary
XX OWWO ... Disposal ... Wildcat XX Cable
... Seismic; ... # of Holes ... Other

Target Formation(s): LKC
Nearest lease or unit boundary: 330'

Ground Surface Elevation: 2404 feet MSL
Water well within one-quarter mile: X yes ... no
Public water supply well within one mile: X yes X no

Depth to bottom of fresh water: 100' 180'
Depth to bottom of usable water: 1200'

Surface Pipe by Alternate: ... 1 X 2
Length of Surface Pipe Planned to be set: N/A 297'
Length of Conductor pipe required: N/A

If OWWO: old well information as follows:
Operator: Sunburst Exploration Co.
Well Name: #1 Keith
Comp. Date: 2/18/82 Old Total Depth: 4015

Projected Total Depth: 4014
Formation at Total Depth: Base KC

Water Source for Drilling Operations:
... well ... farm pond X other

Directional, Deviated or Horizontal wellbore? ... yes X no
If yes, true vertical depth: _____
Bottom Hole Location: _____

Will Cores Be Taken? ... yes X no
If yes, proposed zone: _____

AFFIDAVIT

The undersigned hereby affirms that the drilling, completion and eventual plugging of this well will comply with K.S.A. 55-101, et. seq.

It is agreed that the following minimum requirements will be met:

RECEIVED
STATE CORPORATION COMMISSION

JUN 06 1995

1. Notify the appropriate district office prior to spudding of well;
2. A copy of the approved notice of intent to drill shall be posted on each drilling rig;
3. The minimum amount of surface pipe as specified below shall be set by circulating cement to the top; in all cases surface pipe shall be set through all unconsolidated materials plus a minimum of 20 feet into the underlying formation;
4. If the well is dry hole, an agreement between the operator and the district office on plug length and placement is necessary prior to plugging;
5. The appropriate district office will be notified before well is either plugged or production casing is cemented in;
6. IF AN ALTERNATE II COMPLETION, PRODUCTION PIPE SHALL BE CEMENTED FROM BELOW ANY USABLE WATER TO SURFACE WITHIN 120 DAYS OF SPUD DATE. IN ALL CASES, NOTIFY DISTRICT OFFICE PRIOR TO ANY CEMENTING.

I hereby certify that the statements made herein are true and to the best of my knowledge and belief.

Date: 6/3/1995 Signature of Operator or Agent: Leon Pfeifer Title: Partner

FOR KCC USE:
 API # 15- 065-215510001
 Conductor pipe required NONE feet
 Minimum surface pipe required 297' feet per Alt. X (2)
 Approved by: JK 6-6-95
 This authorization expires: 12-6-95
 (This authorization void if drilling not started within 6 months of effective date.)
 Spud date: _____ Agent: _____

REMEMBER TO:

- File Drill Pit Application (form CDP-1) with Intent to Drill;
- File Completion Form ACO-1 within 120 days of spud date;
- File acreage attribution plat according to field prorator orders;
- Notify appropriate district office 48 hours prior to workover or re-entry;
- Submit plugging report (CP-4) after plugging is completed;
- Obtain written approval before disposing or injecting salt water.

Mail to: KCC - Conservation Division, 130 S. Market - Room 2078, Wichita, Kansas 67202.

19
8
243

IN ALL CASES PLOT THE INTENDED WELL ON THE PLAT BELOW

PLAT OF ACREAGE ATTRIBUTABLE TO A WELL IN A PRORATED OR SPACED FIELD

If the intended well is in a prorated or spaced field, please fully complete this side of the form. If the intended well is in a prorated or spaced field complete the plat below showing that the well will be properly located in relationship to other wells producing from the common source of supply. Please show all the wells within 1 mile of the boundaries of the proposed acreage attribution unit for gas wells and within 1/2 mile of the boundaries of the proposed acreage attribution unit for oil wells.



API NO. 15- _____
 OPERATOR RLT Investment LOCATION OF WELL: COUNTY Graham
 LEASE Keith 990 feet from south/north line of section
 WELL NUMBER #1-19 330 feet from east/west line of section
 FIELD _____ SECTION 19 TWP 8 S RG 24 W

NUMBER OF ACRES ATTRIBUTABLE TO WELL 10 IS SECTION X REGULAR or _____ IRREGULAR
 QTR/QTR/QTR OF ACREAGE NW - SW - SW **IF SECTION IS IRREGULAR, LOCATE WELL FROM NEAREST CORNER BOUNDARY.**

Section corner used: _____ NE _____ NW _____ SE _____ SW

PLAT

(Show location of the well and shade attributable acreage for prorated or spaced wells.)
 (Show footage to the nearest lease or unit boundary line.)

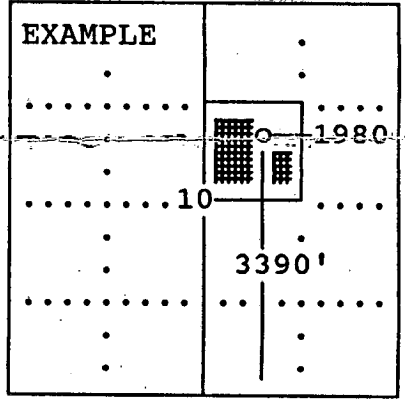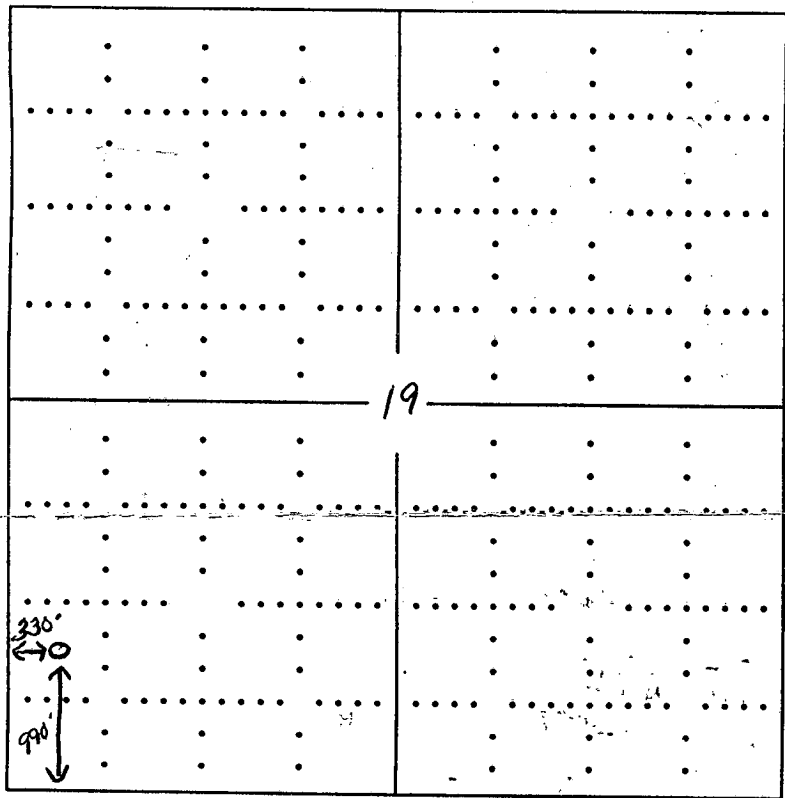

SEWARD CO.

In plotting the proposed location of the well, you must show:

- 1) The manner in which you are using the depicted plat by identifying section lines, i.e. 1 section, 1 section with 8 surrounding sections, 4 sections, etc.;
- 2) the distance of the proposed drilling location from the section's south/north and east/west; and
- 3) the distance to the nearest lease or unit boundary line.