

CARD MUST BE TYPED

State of Kansas
NOTICE OF INTENTION TO DRILL

CARD MUST BE SIGNED

(see rules on reverse side)

Starting Date: 12-3-85
month day year

API Number 15- 065-22,274-00-0

OPERATOR: License # 9542

W/2 SW SW... Sec .. 1 . Twp .. 8 . S, Rge . 24 East
(location) West

Name Robert Myers

Address 11945 Forestwood Drive

City/State/Zip Dallas, TX 75234

Contact Person Jack L. Partridge

Phone 316-262-1841

... 660 Ft North from Southeast Corner of Section

... 4950 Ft West from Southeast Corner of Section

(Note: Locate well on Section Plat on reverse side)

CONTRACTOR: License # 5422

Name Abercrombie Drilling, Inc.

City/State Wichita, KS 67202

Nearest lease or unit boundary line 330 feet.

County Graham KCCZAP

Lease Name Myers-Penokee-Lyon Well# 2 LYON

Domestic well within 330 feet : yes no

Municipal well within one mile : yes no

Well Drilled For: Well Class: Type Equipment:

Oil Swd Infield Mud Rotary

Gas Inj Pool Ext. Air Rotary

OWWO Expl Wildcat Cable

Depth to Bottom of fresh water 150 feet

Lowest usable water formation Dakota

Depth to Bottom of usable water 1350 feet

Surface pipe by Alternate : 1 2

Surface pipe to be set 300 feet

Conductor pipe if any required None feet

Ground surface elevation feet MSL

This Authorization Expires 5-21-86

Approved By 11-21-85 

If OWWO: old well info as follows:

Operator

Well Name

Comp Date Old Total Depth


Projected Total Depth 3800 feet

Projected Formation at TD Lansing/KC

Expected Producing Formations Lansing/KC

I certify that we will comply with K.S.A. 55-101, et seq., plus eventually plugging hole to K.C.C. specifications.

Date 11/14/85 Signature of Operator or Agent

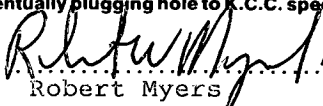
Robert Myers

Title Owner/Operator

RECEIVED

STATE CORPORATION COMMISSION

Must be filed with the K.C.C. five (5) days prior to commencing well


This card void if drilling not started within six (6) months of date received by K.C.C.

NOV 21 1985

11/21/85

CONSERVATION DIVISION
Wichita, Kansas

A Regular Section of Land
1 Mile = 5,280 Ft.

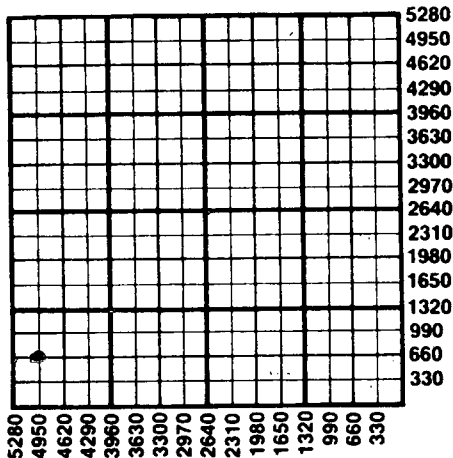

Important procedures to follow :

1. Notify District office before setting surface casing.
2. Set surface casing by circulating cement to the top.
3. File completion forms ACO-1 with K.C.C. within 90 days of well completion, following instructions on ACO-1, side 1, and including copies of wireline logs.
4. Notify District office 48 hours prior to old well workover or re-entry.
5. Prior to plugging, prepare a plugging plan, then obtain agreement from the appropriate district office for an approved plugging plan.
6. Submit plugging report (CP-4) to K.C.C. after plugging is completed.
7. Obtain an approved injection docket number before disposing of salt water.
8. Notify K.C.C. within 10 days when injection commences or terminates.
9. If an alternate 2 completion, cement in the production pipe from below any usable water to surface within 120 days of spud date.

State Corporation Commission of Kansas
Conservation Division
200 Colorado Derby Building
Wichita, Kansas 67202
(316) 263-3238