

CARD MUST BE TYPED

State of Kansas
NOTICE OF INTENTION TO DRILL

(see rules on reverse side)

CARD MUST BE SIGNED

Starting Date: May 14 .. 1985 ..
month day year

API Number 15- 179-20, 815-00-00

OPERATOR: License # 5886

NE. NW. SW. Sec. 35. Twp 8. S, Rge 26. East
(location) West

Name Chief Drilling Co., Inc.

Address 905 Century Plaza Building

City/State/Zip Wichita, Kansas 67202

Contact Person ... Doug Thimesch

Phone 316-262-3791

2310 Ft North from Southeast Corner of Section
4290 Ft West from Southeast Corner of Section
(Note: Locate well on Section Plat on reverse side)

CONTRACTOR: License # 5883

Nearest lease or unit boundary line 330' feet.

County Sheridan

Name Warrior Drilling Co. Rig #1

Lease Name Senger Well# 1

City/State Wichita, Kansas

Domestic well within 330 feet : yes no

~~Well Drilled For: Well Class: Type Equipment:~~

~~Municipal well within one mile : yes no~~

Oil Swd Infield Mud Rotary

Depth to Bottom of fresh water 100 feet

Gas Inj Pool Ext. Air Rotary

Lowest usable water formation Lower Cretaceous

OWWO Expl Wildcat Cable

Depth to Bottom of usable water 1300 feet

If OWWO: old well info as follows:

Surface pipe by Alternate : 1 2

Operator

Surface pipe to be set 225 feet

Well Name

Conductor pipe if any required None feet


Comp Date Old Total Depth

Ground surface elevation will provide feet MSL

Projected Total Depth 4000 feet

This Authorization Expires 11-8-85

Projected Formation at TD Lansing

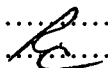Approved By 5-8-85 

Expected Producing Formations Lansing

I certify that we will comply with K.S.A. 55-101, et seq., plus eventually plugging hole to K.G.C. specifications.

Date 5-07-85 Signature of Operator or Agent 

Title Vice President


Douglas W. Thimesch

**Must be filed with the K.C.C. five (5) days prior to commencing well
This card void if drilling not started within six (6) months of date received by K.C.C.**

RECEIVED
STATE CORPORATION COMMISSION
05-08-1985
MAY 8 1985

Important procedures to follow

**A Regular Section of Land
1 Mile = 5,280 Ft.**

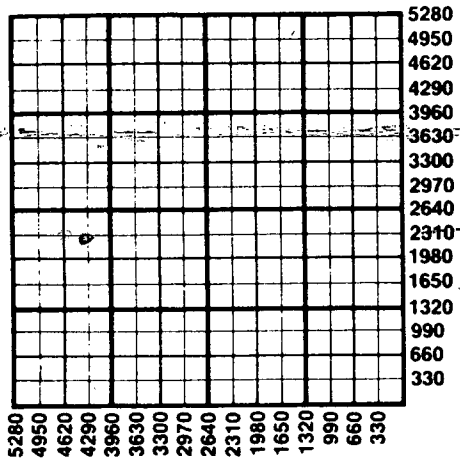

1. Notify District office before setting surface casing.
2. Set surface casing by circulating cement to the top.
3. File completion forms ACO-1 with K.C.C. within 90 days of well completion, following instructions on ACO-1, side 1, and including copies of wireline logs.
4. Notify District office 48 hours prior to old well workover or re-entry.
5. Prior to plugging, prepare a plugging plan, then obtain agreement from the appropriate district office for an approved plugging plan.
6. Submit plugging report (CP-4) to K.C.C. after plugging is completed.
7. Obtain an approved injection docket number before disposing of salt water.
8. Notify K.C.C. within 10 days when injection commences or terminates.
9. If an alternate 2 completion, cement in the production pipe from below any usable water to surface within 120 days of spud date.

**State Corporation Commission of Kansas
Conservation Division
200 Colorado Derby Building
Wichita, Kansas 67202
(316) 263-3238**