

CARD MUST BE TYPED

State of Kansas

CARD MUST BE SIGNED

NOTICE OF INTENTION TO DRILL

OWWO

(see rules on reverse side)

Starting Date 26 month 29 day 87 year

API Number 15- 179-20,219-00-01

OPERATOR: License # 5011

C NW SE Sec. 33 Twp. 8 S, Rg. 28 X West

Name Viking Resources

Address 120 S. Market, Suite 518

City/State/Zip Wichita, KS 67202-3819

Contact Person Jim Devlin

Phone (316) 262-2502

1980 Ft. from South Line of Section

1980 Ft. from East Line of Section

(Note: Locate well on Section Plat on reverse side)

Nearest lease or unit boundary line 660 feet

County Sheridan

Lease Name Shaw Well # 1

Ground surface elevation 2715 feet MSL

Domestic well within 330 feet: yes X no

Municipal well within one mile: yes X no

Depth to bottom of fresh water 150

Depth to bottom of usable water 1600

Surface pipe by Alternate: 1 2 X

Surface pipe planned to be set 21 208

Conductor pipe required None

Projected Total Depth 4099 feet

Formation Base Kansas City

CONTRACTOR: License # 8054

Name Mallard Drilling Corp.

City/State Wichita, KS

Well Drilled For: Well Class: Type Equipment:

X Oil SWD Infield X Mud Rotary

Gas Inj Pool Ext Air Rotary

X OWWO Expl X Wildcat Cable

If OWWO: old well info as follows:

Operator Vannocker & Ropfogel

Well Name Shaw

Comp Date 7-19-69 Old Total Depth 4099

I certify that well will comply with K.S.A. 55-101, et seq., plus eventually plugging hole to KCC specifications.

Date 6-19-87 Signature of Operator or Agent James R. Devlin Title Operator

For KCC Use: Conductor Pipe Required feet; Minimum Surface Pipe Required 208 feet per Alt. X 2


This Authorization Expires 12-22-87 Approved By [Signature] 6-22-87

Must be filed with the K.C.C. five (5) days prior to commencing well
This card void if drilling not started within six (6) months of date received by K.C.C.

Important procedures to follow:

1. Notify District office before setting surface casing.
2. Set surface casing by circulating cement to the top.
3. File completion forms ACO-1 with K.C.C. within 90 days of well completion, following instructions on ACO-1, side 1, and including copies of wireline logs.
4. Notify District office 48 hours prior to old well workover or re-entry.
5. Prior to filing Intent, prepare a proposed plugging plan in case well is D & A, then obtain approval of plan when calling district office prior to setting surface pipe.
6. Submit plugging report (CP-4) to K.C.C. after plugging is completed.
7. Obtain an approved injection docket number before disposing of salt water.
8. Notify K.C.C. within 10 days when injection commences or terminates.
9. If an alternate 2 completion, cement in the production pipe from below any usable water to surface within 120 days of spud date.

A Regular Section of Land 1 Mile = 5,280 Ft.

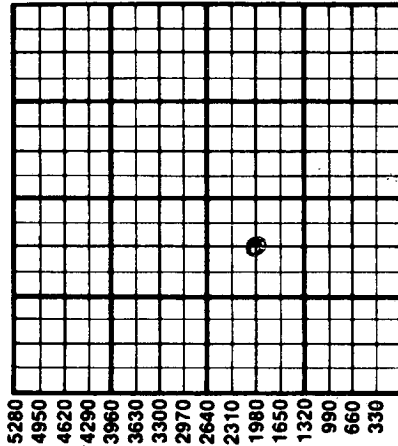

SEED
STATE CORPORATION COMMISSION

JUN 2 1987

CONSERVATION DIVISION
Wichita, Kansas

State Corporation Commission of Kansas
Conservation Division
200 Colorado Derby Building
Wichita, Kansas 67202
(316) 263-3238