

CARD MUST BE TYPED

State of Kansas  
**NOTICE OF INTENTION TO DRILL**

CARD MUST BE SIGNED

(see rules on reverse side)

Starting Date: March 15 1986  
month day year

API Number 15- 193-20,400-00-00  
 East  
 West

OPERATOR: License # 7831  
Name West Kansas Crude Inc.  
Address RR 1 Box 77  
City/State/Zip Selden, Kansas 67757  
Contact Person Charles Young  
Phone 913-475-2766

NW SW Sec 29 Twp 8 S, Rge 32  
(location)  
4730 Ft North from Southeast Corner of Section  
4620 Ft West from Southeast Corner of Section  
(Note: Locate well on Section Plat on reverse side)

CONTRACTOR: License #  
Name Red Tiger Drilling  
City/State Wichita, Kansas

Nearest lease or unit boundary line .550 feet.  
County Thomas  
Lease Name Saddler Well# 1

Well Drilled For: Well Class: Type Equipment:  
 Oil  Swd  Infield  Mud Rotary  
 Gas  Inj  Pool Ext.  Air Rotary  
 OWWO  Expl  Wildcat  Cable

Domestic well within 330 feet:  yes  no  
Municipal well within one mile:  yes  no

If OWWO: old well info as follows:  
Operator  
Well Name  
Comp Date Old Total Depth  
Projected Total Depth 4900 feet  
Projected Formation at TD bottom Mississippian  
Expected Producing Formations LKC, Cherokee, Miss.

Depth to Bottom of fresh water 280 feet  
Lowest usable water formation  
Depth to Bottom of usable water 280 feet  
Surface pipe by Alternate: 1  2   
Surface pipe to be set 300 feet  
Conductor pipe if any required feet  
Ground surface elevation 3128 feet MSL  
This Authorization Expires 9-14-86  
Approved By 3-14-86


I certify that we will comply with K.S.A. 55-101, et seq., plus eventually plugging hole to K.C.C. specifications.

Date 12 March 86 Signature of Operator or Agent Charles Young Title Vice President  
RCA/KC/MSA  
Form C-1 4/84

Must be filed with the K.C.C. five (5) days prior to commencing well  
This card void if drilling not started within six (6) months of date received by K.C.C.

**Important procedures to follow:**

**A Regular Section of Land**  
**1 Mile = 5,280 Ft.**

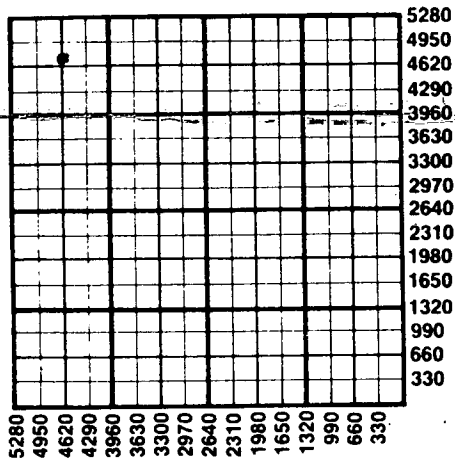

1. Notify District office before setting surface casing.
2. Set surface casing by circulating cement to the top.
3. File completion forms ACO-1 with K.C.C. within 90 days of well completion, following instructions on ACO-1, side 1, and including copies of wireline logs.
4. Notify District office 48 hours prior to old well workover or re-entry.
5. Prior to plugging, prepare a plugging plan, then obtain agreement from the appropriate district office for an approved plugging plan.
6. Submit plugging report (CP-4) to K.C.C. after plugging is completed.
7. Obtain an approved injection docket number before disposing of salt water.
8. Notify K.C.C. within 10 days when injection commences or terminates.
9. If an alternate 2 completion, cement in the production pipe from below any usable water to surface within 120 days of spud date.

STATE CORPORATION COMMISSION

State Corporation Commission of Kansas

MAR 14 1986

Conservation Division

200 Colorado Derby Building

Wichita, Kansas 67202

(316) 263-3238

CONSERVATION DIVISION  
Wichita, Kansas

3-14-86