

NOTICE OF INTENTION TO DRILL

(see rules on reverse side)

Starting Date 30 Oct 30 1986 month day year

API Number 15- 193-20,420-0000

OPERATOR: License # 7831 Name West Kansas Crude Inc. Address RR 1 Box 77 City/State/Zip Selden, Kansas 67757 Contact Person Chuck Young Phone 913-475-2766

C SE NE Sec 30 Twp 8 S, Rg 32 3300 Ft. from South Line of Section 660 Ft. from East Line of Section

(Note: Locate well on Section Plat on reverse side)

CONTRACTOR: License # 5302 Name Red Tiger Drilling Co. City/State Wichita, Kansas

Nearest lease or unit boundary line 660 feet County Thomas Lease Name Kindig Well # 2 Ground surface elevation N A feet MSL Domestic well within 330 feet: yes no Municipal well within one mile: yes no Depth to bottom of fresh water 180 Depth to bottom of usable water 250 Surface pipe by Alternate: 1 2 Surface pipe planned to be set 300 Conductor pipe required Projected Total Depth 4950 Formation Base Mississippian

Well Drilled For: Oil SWD Gas Inj OWWO Expl Well Class: Infield Pool Ext Wildcat Type Equipment: Mud Rotary Air Rotary Cable

If OWWO: old well info as follows:

Operator Well Name Comp Date Old Total Depth

I certify that well will comply with K.S.A. 55-101, et seq., plus eventually plugging hole to KCC specifications.

Date 28 Oct 86 Signature of Operator or Agent Chuck Young Title Vice President

For KCC Use:

Conductor Pipe Required 300 feet; Minimum Surface Pipe Required 300 feet per Alt. This Authorization Expires 4-29-87 Approved By 10-29-86


Handwritten signature and initials at bottom right.

Must be filed with the K.C.C. five (5) days prior to commencing well  
This card void if drilling not started within six (6) months of date received by K.C.C.

### Important procedures to follow:

1. Notify District office before setting surface casing.
2. Set surface casing by circulating cement to the top.
3. File completion forms ACO-1 with K.C.C. within 90 days of well completion, following instructions on ACO-1, side 1, and including copies of wireline logs.
4. Notify District office 48 hours prior to old well workover or re-entry.
5. Prior to filing Intent, prepare a proposed plugging plan in case well is D & A, then obtain approval of plan when calling district office prior to setting surface pipe.
6. Submit plugging report (CP-4) to K.C.C. after plugging is completed.
7. Obtain an approved injection docket number before disposing of salt water.
8. Notify K.C.C. within 10 days when injection commences or terminates.
9. If an alternate 2 completion, cement in the production pipe from below any usable water to surface within 120 days of spud date.

### A Regular Section of Land 1 Mile = 5,280 Ft.

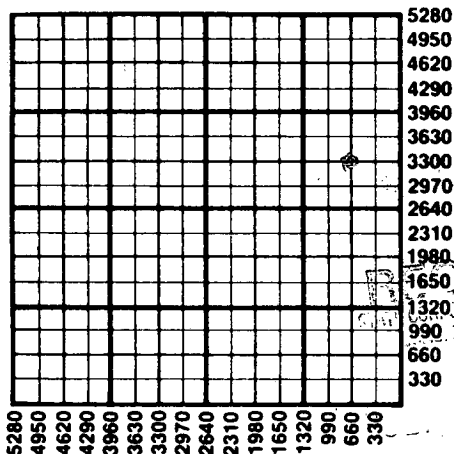

RECEIVED  
OCT 29 1986  
STATE CORPORATION COMMISSION  
DIV. WICHITA, KS

10-29-86

State Corporation Commission of Kansas  
Conservation Division  
200 Colorado Derby Building  
Wichita, Kansas 67202  
(316) 263-3238