

CARD MUST BE TYPED

State of Kansas

CARD MUST BE SIGNED

NOTICE OF INTENTION TO DRILL

(see rules on reverse side)

Starting Date September 2, 1986
month day year

API Number 15- 193-20,413-00-00

OPERATOR: License # 4569
Name Jay Boy Oil, Inc.
Address 8400 Killarney
City/State/Zip Wichita, KS, 67206
Contact Person C.K. Morrison
Phone 316-263-5781

SE. SW NE Sec. 28 Twp. 8 S, Rg. 33 X West
2970 Ft. from South Line of Section
1650 Ft. from East Line of Section

(Note: Locate well on Section Plat on reverse side)

CONTRACTOR: License # 5418
Name Allen Drilling Co.
City/State Great Bend, Kansas

Nearest lease or unit boundary line 378 feet
County Thomas
Lease Name H & H Farms Well # 1 - F

Well Drilled For: Well Class: Type Equipment:
X Oil — SWD — Infield X Mud Rotary
— Gas — Inj — Pool Ext. — Air Rotary
— OWWO — Expl X Wildcat — Cable

Ground surface elevation 3169 feet MSL
Domestic well within 330 feet: —yes Xno
Municipal well within one mile: —yes Xno
Depth to bottom of fresh water 180' 200'
Depth to bottom of usable water 250'
Surface pipe by Alternate: 1 X 2
Surface pipe planned to be set 250'
Conductor pipe required no
Projected Total Depth 5200 feet
Formation Arbuckle

If OWWO: old well info as follows:

Operator
Well Name
Comp Date Old Total Depth

I certify that well will comply with K.S.A. 55-101, et seq., plus eventually plugging hole to KCC specifications.

Date 8-15-86 Signature of Operator or Agent C.K. Morrison Title Operations Manager

For KCC Use:

Conductor Pipe Required feet; Minimum Surface Pipe Required 250 feet per Alt. (1) X
This Authorization Expires 2-15-87 Approved By Per 8-15-86


Must be filed with the K.C.C. five (5) days prior to commencing well
This card void if drilling not started within six (6) months of date received by K.C.C.

Important procedures to follow:

1. Notify District office before setting surface casing.
2. Set surface casing by circulating cement to the top.
3. File completion forms ACO-1 with K.C.C. within 90 days of well completion, following instructions on ACO-1, side 1, and including copies of wireline logs.
4. Notify District office 48 hours prior to old well workover or re-entry.
5. Prior to filing Intent, prepare a proposed plugging plan in case well is D & A, then obtain approval of plan when calling district office prior to setting surface pipe.
6. Submit plugging report (CP-4) to K.C.C. after plugging is completed.
7. Obtain an approved injection docket number before disposing of salt water.
8. Notify K.C.C. within 10 days when injection commences or terminates.

A Regular Section of Land
1 Mile = 5,280 Ft.

R33W

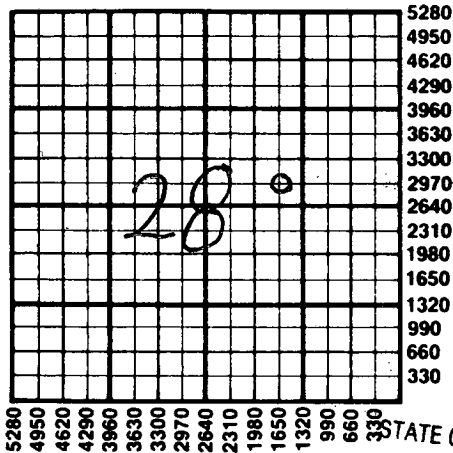

RECEIVED

STATE CORPORATION COMMISSION

AUG 15 1986

8-15-86

CONSERVATION DIVISION
Wichita, Kansas

State Corporation Commission of Kansas
Conservation Division
200 Colorado Derby Building
Wichita, Kansas 67202
(316) 263-3238

Jay Boy Oil, Inc.
#1 H & H Farms "F"
Thomas County