

NOTICE OF INTENTION TO DRILL

(see rules on reverse side)

Starting Date May 5 1986 month day year

API Number 15- 193-20,403-00-00

OPERATOR: License # 4569
Name Jay Boy Oil, Inc.
Address 8400 Killarney
City/State/Zip Wichita, Kansas 67206
Contact Person C.K. Morrison
Phone 316-263-5781

SW SW SE Sec 34 Twp 8 S, Rg 33 X West
330 Ft. from South Line of Section
2310 Ft. from East Line of Section

(Note: Locate well on Section Plat on reverse side)

CONTRACTOR: License # 5418
Name Allen Drilling Co.
City/State Great Bend, Kansas

Nearest lease or unit boundary line 330 feet
County Thomas
Lease Name H & H Farms Well # 1

Well Drilled For: Well Class: Type Equipment:
X Oil SWD Infield X Mud Rotary
Gas Inj Pool Ext Air Rotary
OWWO Expl X Wildcat Cable

Ground surface elevation 3134 feet MSL
Domestic well within 330 feet: yes X no
Municipal well within one mile: yes X no
Depth to bottom of fresh water 250' 150'
Depth to bottom of usable water 250'
Surface pipe by Alternate: 1 X 2
Surface pipe planned to be set 250' c/w
Conductor pipe required None
Projected Total Depth 5900 feet
Formation Pre-Cambrian

If OWWO: old well info as follows:
Operator
Well Name
Comp Date Old Total Depth

I certify that well will comply with K.S.A. 55-101, et seq, plus eventually plugging hole to KCC specifications.
Date 4-30-86 Signature of Operator or Agent Jay Abiah Title President

For KCC Use:
Conductor Pipe Required feet; Minimum Surface Pipe Required feet per Alt 11
This Authorization Expires 10-30-86 Approved By 4-30-86


Must be filed with the K.C.C. five (5) days prior to commencing well  
This card void if drilling not started within six (6) months of date received by K.C.C.

**Important procedures to follow:**

1. Notify District office before setting surface casing.
2. Set surface casing by circulating cement to the top.
3. File completion forms ACO-1 with K.C.C. within 90 days of well completion, following instructions on ACO-1, side 1, and including copies of wireline logs.
4. Notify District office 48 hours prior to old well workover or re-entry.
5. Prior to filing Intent, prepare a proposed plugging plan in case well is D & A, then obtain approval of plan when calling district office prior to setting surface pipe.
6. Submit plugging report (CP-4) to K.C.C. after plugging is completed.
7. Obtain an approved injection docket number before disposing of salt water.
8. Notify K.C.C. within 10 days when injection commences or terminates.

**A Regular Section of Land  
1 Mile = 5,280 Ft.**

R 33W

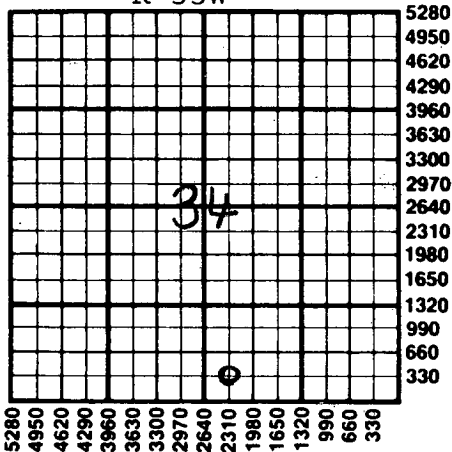

T 8S

RECEIVED  
STATE CORPORATION COMMISSION

If an alternate 2 completion, cement in the production pipe from below any usable water to surface within 120 days of spud date.

JAY BOY OIL, INC.  
#1 H & H Farms

4-30-86

APR 30 1986

CONSERVATION DIVISION  
Wichita, Kansas

State Corporation Commission of Kansas  
Conservation Division  
200 Colorado Derby Building  
Wichita, Kansas 67202  
(316) 263-3238