

NOTICE OF INTENTION TO DRILL

(see rules on reverse side)

Starting Date February 1 1986 month day year

API Number 15- 141-20,224-00-00

OPERATOR: License # KCC 4781 Name IKE Enterprises Address RR 1, Box 132 City/State/Zip Natoma, Kansas 67651 Contact Person W. Keith Elliott Phone 913-885-4848

SW NE NE Sec. 29 Twp. 9 S, Rg. 14 West 4290 Ft. from South Line of Section 990 Ft. from East Line of Section

(Note: Locate well on Section Plat on reverse side)

CONTRACTOR: License # 5302 Name Red Tiger Drilling Co. City/State Wichita, Kansas 67202

Nearest lease or unit boundary line 990 feet County Osborne Lease Name Delaney Well # 1

Well Drilled For: Well Class: Type Equipment: X Oil SWD Infield X Mud Rotary Gas Inj Pool Ext Air Rotary OWWO Expl X Wildcat Cable

Ground surface elevation 2031 feet MSL Domestic well within 330 feet: yes X no Municipal well within one mile: yes X no Surface pipe by Alternate: 1 2 X Depth to bottom of fresh water 100 Depth to bottom of usable water 500 800 Surface pipe planned to be set 250 Projected Total Depth 3700 feet Formation Conglomerate

If OWWO: old well info as follows:

Operator Well Name Comp Date Old Total Depth

I certify that well will comply with K.S.A. 55-101, et seq., plus eventually plugging hole to KCC specifications.

Date 1-18-1986 Signature of Operator or Agent W. Keith Elliott Title Owner

For KCC Use:


Conductor Pipe Required feet; Minimum Surface Pipe Required feet per Alt. This Authorization Expires 7-22-86 Approved By 1-22-86

Must be filed with the K.C.C. five (5) days prior to commencing well
This card void if drilling not started within six (6) months of date received by K.C.C.

Important procedures to follow:

1. Notify District office before setting surface casing.
2. Set surface casing by circulating cement to the top.
3. File completion forms ACO-1 with K.C.C. within 90 days of well completion, following instructions on ACO-1, side 1, and including copies of wireline logs.
4. Notify District office 48 hours prior to old well workover or re-entry.
5. Prior to filing Intent, prepare a proposed plugging plan in case well is D & A, then obtain approval of plan when calling district office prior to setting surface pipe.
6. Submit plugging report (CP-4) to K.C.C. after plugging is completed.
7. Obtain an approved injection docket number before disposing of salt water.
8. Notify K.C.C. within 10 days when injection commences or terminates.
9. If an alternate 2 completion, cement in the production pipe from below any usable water to surface within 120 days of spud date.

A Regular Section of Land
1 Mile = 5,280 Ft.

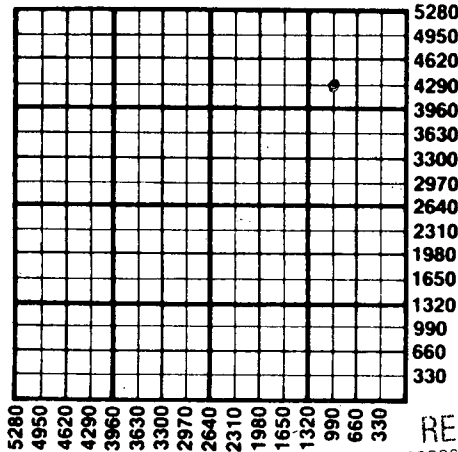

RECEIVED
STATE CORPORATION COMMISSION

JAN 22 1986
CONSERVATION DIVISION
Wichita, Kansas

1-22-86

State Corporation Commission of Kansas
Conservation Division
200 Colorado Derby Building
Wichita, Kansas 67202
(316) 263-3238