

\*\*\*\* CORRECTED\*\*\*\* NOTICE OF INTENTION TO DRILL

(see rules on reverse side)

Expected Spud Date... 10... 10... 1988  
month day year

API Number 15- 141-20,241 -00-00 VDA

OPERATOR: License # 6588  
Name Woodman-Iannitti Oil Company  
Address P.O. Box 308  
City/State/Zip Great Bend, KS. 67530  
Contact Person D. J. Iannitti  
Phone (316) 792-2921

\*\*SE SW NE Sec. 7 Twp. 9 S, Rg. 15 East XX West  
2970 Ft. from South Line of Section  
\*\* 1650 Ft. from East Line of Section

(Note: Locate well on Section Plat on reverse side)

CONTRACTOR: License # 5122  
Name Woodman-Iannitti Drilling Company  
City/State Great Bend, KS. 67530

Nearest lease or unit boundary line 330 feet  
County OSBORNE  
Lease Name DEUCHNER Well # 1

Well Drilled For: Well Class: Type Equipment:  
X Oil Storage Infield X Mud Rotary  
Gas Inj Pool EXT Air Rotary  
OWWO Expl X Wildcat Cable

Ground surface elevation feet MSL  
Domestic well within 330 feet: yes X no  
Municipal well within one mile: yes X no

If OWWO: old well info as follows:  
Operator  
Well Name  
Comp Date Old Total Depth

CORRECTED 10-6-88

Depth to bottom of fresh water 170'  
Depth to bottom of usable water 820'  
Surface pipe by Alternate: 1 XX  
Surface pipe planned to be set 200'  
Conductor pipe required  
Projected Total Depth 3700 feet  
Formation Conglomerate

I certify that well will comply with K.S.A. 55-101, et seq., plus eventually plugging hole to KCC specifications.  
Date 10/03/88 Signature of Operator or Agent D.J. Iannitti Title Partner

For KCC Use:  
Conductor Pipe Required feet; Minimum Surface Pipe Required 200' feet per Alt. X (2)  
This Authorization Expires 3-9-89 Approved By KCM 10-6-88 Date Rec'd: 9-9-88

EFFECTIVE DATE: 9-14-88


\*WAS: S/2 SW NE, 1980' FEL

Must be filed with the K.C.C. five (5) days prior to commencing well  
This card void if drilling-not-started within six (6) months of date received by K.C.C.

### Important procedures to follow:

1. Notify District office before setting surface casing.
2. Set surface casing by circulating cement to the top.
3. File completion forms ACO-1 with K.C.C. within 120 days of well spud date, following instructions on ACO-1, side 1, and including copies of wireline logs.
4. Notify District office 48 hours prior to old well workover or re-entry.
5. Prior to filing Intent, prepare a proposed plugging plan in case well is D & A, then obtain approval of plan when calling district office prior to setting surface pipe.
6. Submit plugging report (CP-4) to K.C.C. after plugging is completed.
7. Obtain an approved injection docket number before disposing of salt water.
8. Notify K.C.C. within 10 days when injection commences or terminates.
9. If an alternate 2 completion, cement in the production pipe from any usable water to surface within 120 days of spud date.

### A Regular Section of Land 1 Mile = 5,280 Ft.

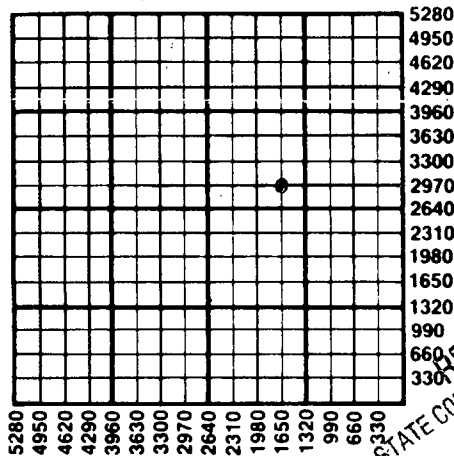

RECEIVED  
OCT 5 1988  
STATE CORPORATION COMMISSION  
CONSERVATION DIVISION  
Wichita, Kansas  
10-5-88

State Corporation Commission of Kansas  
Conservation Division  
200 Colorado Derby Building  
Wichita, Kansas 67202-1212  
(316) 263-3238