


Give All Information Completely
Make Required Affidavit
Mail or Deliver Report to:
Conservation Division
State Corporation Commission
212 No. Market
Wichita, Kansas

WELL PLUGGING RECORD

NORTH

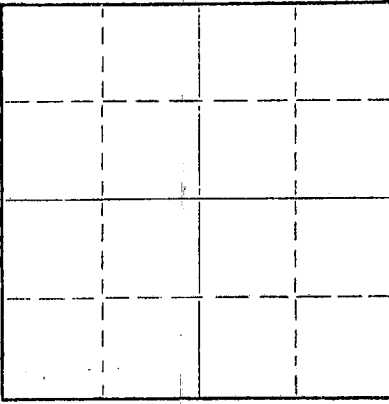

Locate well correctly on above
Section Plat

Thomas County, Sec. 7 Twp. 8S Rge. (E35) (W)
Location as "NE/CNW/SW" or footage from lines C SE SW
Lease Owner Slawson Drilling Co., Inc.
Lease Name Garvey "A" Well No. 1
Office Address 408 One Twenty Building-Wichita, Kansas 67202
Character of Well (completed as Oil, Gas or Dry Hole) Dry Hole
Date well completed April 25, 1969
Application for plugging filed April 25, 1969
Application for plugging approved April 25, 1969
Plugging commenced April 25, 1969
Plugging completed April 25, 1969
Reason for abandonment of well or producing formation

If a producing well is abandoned, date of last production 19
Was permission obtained from the Conservation Division or its agents before plugging was commenced? Yes

Name of Conservation Agent who supervised plugging of this well W. L. Nichols
Producing formation Depth to top Bottom Total Depth of Well 4930 Feet
Show depth and thickness of all water, oil and gas formations.

OIL, GAS OR WATER RECORDS

CASING RECORD

FORMATION	CONTENT	FROM	TO	SIZE	PUT IN	PULLED OUT
		0	248'	8-5/8"	248'	None

Describe in detail the manner in which the well was plugged, indicating where the mud fluid was placed and the method or methods used in introducing it into the hole. If cement or other plugs were used, state the character of same and depth placed, from feet to feet for each plug set.

Filled hole with heavy mud to 1920 feet. Set first plug at 1920 feet w/100 sacks cement.
Filled hole with heavy mud to 275 feet. Set second plug at 275 feet w/20 sacks cement.
Filled hole with heavy mud to 40 feet. Set top plug at 40 feet w/10 sacks cement.
Job by Halliburton. Job complete at 2:00 PM.

RECEIVED
STATE CORPORATION COMMISSION
MAY 12 1969
CONSERVATION DIVISION
Wichita, Kansas

5-12-69

(If additional description is necessary, use BACK of this sheet)

Name of Plugging Contractor Gabbert-Jones, Inc.
Address 830 Sutton Place - Wichita, Kansas 67202

STATE OF Kansas, COUNTY OF Sedgwick, ss.
E. E. Hall (employee of owner) or (owner or operator) of the above-described well, being first duly sworn on oath, says: That I have knowledge of the facts, statements, and matters herein contained and the log of the above-described well as filed and that the same are true and correct. So help me God.

(Signature) E. E. Hall

830 Sutton Place, Wichita, Kansas 67202
(Address)

SUBSCRIBED AND SWORN TO before me this 9 day of May, 1969

Barbara J. Layton
Barbara J. Layton Notary Public.

Feb. 1, 1972.

