


15193-00010-00-00

WELL PLUGGING RECORD

Give All Information Completely
Make Required Affidavit
Mail or Deliver Report to:
Conservation Division
State Corporation Commission
800 Bitting Building
Wichita, Kansas

Thomas County. Sec. 27 Twp. 8s Rge. 35 (E) (W)

NORTH

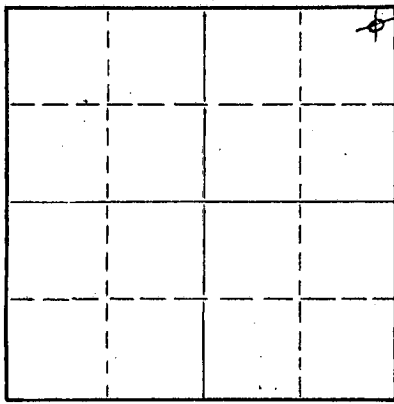

Locate well correctly on above Section Plat

Location as "NE/CNW&SW&" or footage from lines C NE NE NE
Lease Owner Virginia Drlg Co Inc.
Lease Name Faulkner Well No. 1
Office Address 712 Brown Bldg-Wichita 2, Kansas
Character of Well (completed as Oil, Gas or Dry Hole) DH
Date well completed 6-29-58 19
Application for plugging filed " 19
Application for plugging approved " 19
Plugging commenced " 19
Plugging completed " 19
Reason for abandonment of well or producing formation _____

If a producing well is abandoned, date of last production _____ 19
Was permission obtained from the Conservation Division or its agents before plugging was commenced? yes

Name of Conservation Agent who supervised plugging of this well A. D. Fabricius
Producing formation _____ Depth to top _____ Bottom _____ Total Depth of Well 4840 Feet
Show depth and thickness of all water, oil and gas formations.

OIL, GAS OR WATER RECORDS

CASING RECORD

FORMATION	CONTENT	FROM	TO	SIZE	PUT IN	PULLED OUT
		0	216	8 5/8"	216	none

Describe in detail the manner in which the well was plugged, indicating where the mud fluid was placed and the method or methods used in introducing it into the hole. If cement or other plugs were used, state the character of same and depth placed, from _____ feet to _____ feet for each plug set.

Mudded to 600 ft - set plug w/25 sx cement
" 215 ft - set plug w/15 sx cement
" 40 ft. - set plug w/ 10 sx cement

RECEIVED
STATE CORPORATION COMMISSION

JUL 7 1958

CONSERVATION DIVISION
Wichita, Kansas


7-7-58

(If additional description is necessary, use BACK of this sheet)
Name of Plugging Contractor Virginia Drlg Co Inc.
Address 712 Brown Bldg-Wichita 2, Kansas

STATE OF Kansas, COUNTY OF Sedgwick, ss.
S. A. Murphy (employee of owner) or (owner or operator) of the above-described well, being first duly sworn on oath, says: That I have knowledge of the facts, statements, and matters herein contained and the log of the above-described well as filed and that the same are true and correct. So help me God.

(Signature) [Signature]
712 Brown Bldg.-Wichita 2, Kansas
(Address)

SUBSCRIBED AND SWORN TO before me this 2nd day of July, 1958
[Signature] Notary Public.

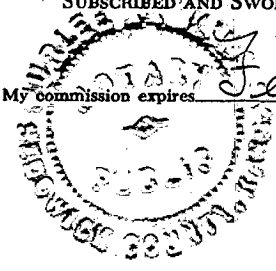

PLUGGING
FILE SEC 27 T. 8 R. 35W
BOOK PAGE 113 LINE 26

Faulkner # 1 - C NE NE NE Sec. 27-8s-35w Thomas County, Kansas
Company - Virginia Drilling Co., Inc.
Contractor - same
Commenced - June 12, 1958
Completed - June 29, 1958
Elevation - 3273 KB
Total Depth - 4840

8 5/8" set at 216 ft w/140 sx cem.

Dry hole

FORMATION	DEPTH	
Clay-sand	0- 115	
Sand-shale	115- 190	
Shale-shells	190-1815	TOPS:
Anhydrite	1815-1840	4086 - Heebner
Shale-lime	1840-2205	4117 - Toronto
Shale-lime shells	2205-2510	4133 - Lansing KC
Shale-lime	2510-3545	4586 - Cherokee
Lime-snad	3545-3580	4738 - Mississippi
Lime-shale	3580-3965	
Lime	3965-4744	
Lime-chert	4744-4761	
Lime	4761-4840 TD	

S. A. Murphy
S. A. Murphy

Subscribed and sworn to before me, a Notary Public,
this 3rd day of July, 1958.

W. J. ...
Notary Public

My commission expires: Febr. 5, 1961.

PLUGGING
FILE SEC. 27 T. 8 R. 35W
BOOK PAGE 113 LINE 26

7-7-58