

Give All Information Completely
Make Required Affidavit
Mail or Deliver Report to:
Conservation Division
State Corporation Commission
212 North Market, Insurance Bldg.
Wichita, Kansas

WELL PLUGGING RECORD

Thomas County, Sec. 27 Twp. 8 S Rge. (E) 6 (W)

Location as "NE/CNW%SW%" or footage from lines: C NE NW

Lease Owner Target Drilling Corp

Lease Name Hanson Well No. 1

Office Address 910 Enterprise Bldg. Tulsa 3, Oklahoma

Character of Well (completed as Oil, Gas or Dry Hole) Dry Hole

Date well completed 6-11 19 61

Application for plugging filed 6-11 19 61

Application for plugging approved 6-11 19 61


Plugging commenced 6-11 19 61

Plugging completed 6-11 19 61

Reason for abandonment of well or producing formation No productive horizons encountered

If a producing well is abandoned, date of last production 19

Was permission obtained from the Conservation Division or its agents before plugging was commenced? yes

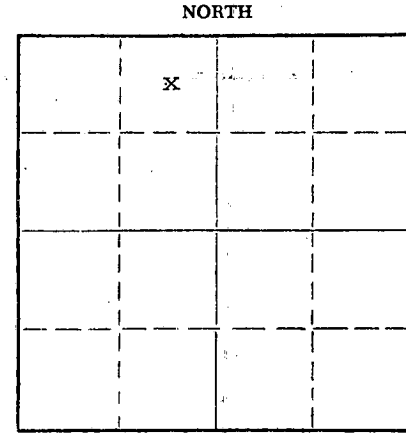

Locate well correctly on above Section Plat

Name of Conservation Agent who supervised plugging of this well Mr. Fabricus, Hill City, Kansas

Producing formation none Depth to top x Bottom x Total Depth of Well 4876' Feet

Show depth and thickness of all water, oil and gas formations.

OIL, GAS OR WATER RECORDS

CASING RECORD

FORMATION	CONTENT	FROM	TO	SIZE	PUT IN	PULLED OUT
Water Sand	Fresh Water			8 5/8	125'	

Describe in detail the manner in which the well was plugged, indicating where the mud fluid was placed and the method or methods used in introducing it into the hole. If cement or other plugs were used, state the character of same and depth placed, from feet to feet for each plug set.

Set cement plug at 550' with twenty sacks cement, filled hole with Mud to 135' and set cement plug with twenty sacks of cement, filled hole with Mud to 35' from surface, set plug with ten sacks cement with two wires attached to plug and extending to surface.

RECEIVED
STATE CORPORATION COMMISSION

JUN 19 1961

CONSERVATION DIVISION
Wichita, Kansas

Name of Plugging Contractor Halliburton Company (If additional description is necessary, use BACK of this sheet) 6-19-61
Address Atwood, Kansas

STATE OF Oklahoma, COUNTY OF Tulsa, ss.

J. W. Garner (employee of owner) or (owner or operator) of the above-described well, being first duly sworn on oath, says: That I have knowledge of the facts, statements, and matters herein contained and the log of the above-described well as filed and that the same are true and correct. So help me God.

(Signature) J.W. Garner
910 Enterprise Bldg. Tusa, Oklahoma

(Address)

SUBSCRIBED AND SWORN TO before me this 16 day of June, 19 61

My commission expires Nov. 13, 1963
Karel Heenan
Notary Public.



24

TARGET DRILLING CORPORATION
No 1 Hanson NE/4 NW/4 Sec 27-4S-36W
Thomas County, Kansas

DRILLERS SAMPLE DESCRIPTION

0 - 956	Sand Lime
956-1500	Lime & Shale
1500-1860	ND
1860-2090	Shale, Lime and Sand
2090-2199	Lime
2199-2550	Shale and Lime
2550-2551	Lime'
2551-2565	Sand
2565-2663	Lime and Sand
2663-3185	Lime and Shale
3185-3239	Red Lime
3239-3428	Lime and Shale
3428-3520	Red Bed
3520-3793	Shale & Lime
3793-4686	Lime
4686-4702	ND
4702-4742	Lime and Shale
4742-4807	Lime
4807-4842	Lime and Sand
4842-4852	ND
4852-4876	Lime

RECEIVED
STATE CORPORATION COMMISSION

JUN 19 1961


6-19-61
CONSERVATION DIVISION
Wichita, Kansas

J. W. Garner

J. W. Garner

State of Oklahoma)
County of Tulsa)

Subscribed and sworn to me a Notary Public this 16th
day of June 1961

 

Sylva Lockhart

Notary Public

My Commission expires 10/15/63