

This form shall be filed in duplicate with the Kansas Corporation Commission, 200 Colorado Derby Building, Wichita, Kansas 67202, within ten days after the completion of the well, regardless of how the well was completed.

Attach separate letter of request if the information is to be held confidential. If confidential, only file one copy. Information on side one will be of public record and side two will then be held confidential.

Circle one: Oil Gas, Dry, SWD, OWWO, Injection. Type and complete ALL sections. Applications must be filed for dual completion, commingling, SWD and injection.

Attach wireline logs (i.e. electrical log, sonic log, gamma ray neutron log, etc.). KCC # (316) 263-3238. (Rules 82-2-105 & 82-2-125)

OPERATOR Graham-Michaelis Corporation

API NO. 15-141-20,116-00-00

ADDRESS P. O. Box 247  
Wichita, Kansas 67201

COUNTY Osborne

FIELD HACHMEISTER

\*\*CONTACT PERSON Jack L. Yinger  
PHONE (316) 264-8394

PROD. FORMATION Toronto & Lansing

PURCHASER Koch Oil Company

LEASE Hachmeister

ADDRESS P. O. Box 2256  
Wichita, Kansas 67201

WELL NO. 2 - 31

WELL LOCATION Approx. SE SW SW


DRILLING Revlin Drilling, Inc.  
CONTRACTOR  
ADDRESS P. O. Box 88  
Russell, Kansas 67665

340 Ft. from South Line and

1020 Ft. from West Line of

the SW/4 SEC. 31 TWP. 9S RGE. 15W

WELL PLAT

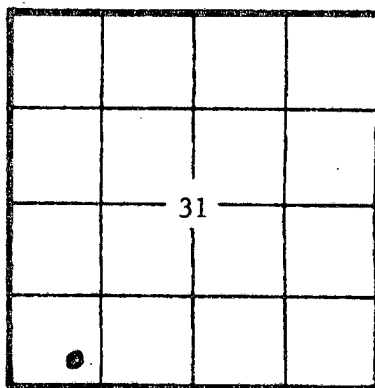

KCC   
KGS   
(Office Use)

PLUGGING  
CONTRACTOR  
ADDRESS

TOTAL DEPTH 3640' PBDT 3537.80'

SPUD DATE 9/13/81 DATE COMPLETED 10/13/81

ELEV: GR 2012' DF KB 2017'

DRILLED WITH (CONEX) (ROTARY) (KEX) TOOLS

Amount of surface pipe set and cemented 254' DV Tool Used?

AFFIDAVIT

RECEIVED  
STATE CORPORATION COMMISSION  
12-31-1981  
DEC 31 1981

STATE OF Kansas, COUNTY OF Sedgwick, SS, I,

Jack L. Yinger OF LAWFUL AGE, BEING FIRST DULY SWORN UPON HIS OATH  
DEPOSES THAT HE IS Vice President (FOR)(OF) Graham-Michaelis Corporation  
Wichita, Kansas

OPERATOR OF THE Hachmeister LEASE, AND IS DULY AUTHORIZED TO MAKE

THIS AFFIDAVIT FOR AND ON THE BEHALF OF SAID OPERATOR, THAT WELL NO. 2 - 31 ON

SAID LEASE HAS BEEN COMPLETED AS OF THE 12th DAY OF October, 19 81, AND THAT

ALL INFORMATION ENTERED HEREIN WITH RESPECT TO SAID WELL IS TRUE AND CORRECT.

FURTHER AFFIANT SAITH NOT.

(S) Jack L. Yinger

SUBSCRIBED AND SWORN BEFORE ME THIS 28th DAY OF December, 19 81.

ALDINE M. JOHNSON  
NOTARY PUBLIC  
STATE OF KANSAS  
My Appointment Expires 12/31/85

Aldine M. Johnson  
NOTARY PUBLIC

MY COMMISSION EXPIRES:

\*\*The person who can be reached by phone regarding any questions concerning this information. Within 45 days of completion, a witnessed initial test by the Commission is required if the well produces more than 25 BOPD or is located in a Basic Order Pool.

PLEASE KEEP THIS INFORMATION CONFIDENTIAL