

15-163-01019-00-00


WELL PLUGGING RECORD

STATE OF KANSAS
STATE CORPORATION COMMISSION

Give All Information Completely
Make Required Affidavit
Mail or Deliver Report to:
Conservation Division
State Corporation Commission
211 No. Broadway
Wichita, Kansas

Rooks County. Sec. 7 Twp. 9 Rge. 19 (X) W (W)

Location as "NE/CNW $\frac{1}{4}$ SW $\frac{1}{4}$ " or footage from lines SW SW NE
Lease Owner Nadel and Gussman
Lease Name Fregeau Well No. 1
Office Address 1714 First Natl Bldg, Tulsa 3, Oklahoma
Character of Well (completed as Oil, Gas or Dry Hole) Dry
Date well completed 12-19-57
Application for plugging filed 12-19-57
Application for plugging approved 12-19-57
Plugging commenced 12-19-57
Plugging completed 12-19-57
Reason for abandonment of well or producing formation Dry

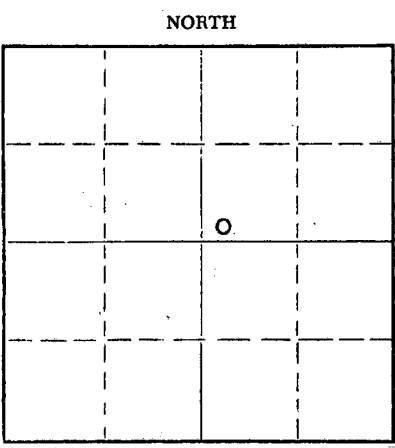

Locate well correctly on above Section Plat

If a producing well is abandoned, date of last production 19
Was permission obtained from the Conservation Division or its agents before plugging was commenced? Yes

Name of Conservation Agent who supervised plugging of this well Eldon Petty
Producing formation _____ Depth to top _____ Bottom _____ Total Depth of Well 3650 Feet
Show depth and thickness of all water, oil and gas formations.

OIL, GAS OR WATER RECORDS

CASING RECORD

FORMATION	CONTENT	FROM	TO	SIZE	PUT IN	PULLED OUT
				8-5/8"	204'	0

Describe in detail the manner in which the well was plugged, indicating where the mud fluid was placed and the method or methods used in introducing it into the hole. If cement or other plugs were used, state the character of same and depth placed, from _____ feet to _____ feet for each plug set.

Filled hole with heavy mud from T.D. to 600', set plug and cemented with 20 sax -
Filled hole with heavy mud from 600' to 180' and set second plug with 20 sax
Set top plug at 40' and cemented with 10 sax to top

RECEIVED
STATE CORPORATION COMMISSION

JAN 2 1958

CONSERVATION DIVISION
WICHITA, KANSAS

1-2-58

(If additional description is necessary, use BACK of this sheet)
Name of Plugging Contractor Reserve Drilling Company, Inc.
Address 625 Union Center, Wichita 2, Kansas

STATE OF KANSAS, COUNTY OF SEDGWICK, ss.
L. C. Hay (employee of owner) or (owner or operator) of the above-described well, being first duly sworn on oath, says: That I have knowledge of the facts, statements, and matters herein contained and the log of the above-described well as filed and that the same are true and correct. So help me God.

(Signature) L. C. Hay
Wichita, Kansas (Address)

SUBSCRIBED AND SWORN to before me this 23rd day of December 1957
My commission expires Nov. 3, 1960
Rosa Babb Notary Public.

PLUGGING
FILE SEC 7 T 9 R 19W
BOOK PAGE 71 LINE 42



Nadel and Gussman

Fregeau No. 1

SW SW NE 7-9-19W
Rooks County, Kansas

Comm: 12-10-57
Comp: 12-19-57

Casing: 8-5/8" 204' with 125 Sax

<u>Formations</u>	<u>Depth</u>
Shale and sand	207
Shale and shells	915
Shale, sand & pyrite Stks.	1005
Sand	1210
Shale	1518
Anhydrite	1552
Shale and shells	2100
Shale and lime streaks	2190
Lime and shale	3185
Lime	3240
Lime and shale	3350
Lime	3520
Lime and shale	3580
Lime, shale and chert	3610
Lime	3640
Arbuckle Lime	3650

Geological Tops

Topeka	3064
Heebner	3263
Toronto	3287
Lansing	3302
Base Kansas City	3511
Conglomerate	3555
Arbuckle	3610

STATE OF KANSAS)
) SS:
COUNTY OF SEDGWICK)


L. C. Hay, of lawful age, states that the above formations and depths are correct to his best knowlege.

L.C. Hay

Subscribed and sworn to before me this 23rd day of December, 1957.

Paul Bass
Notary Public

My commission expires Nov. 3, 1960

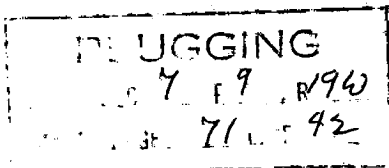

1-2-58