


OR
FORMATION PLUGGING RECORD

Strike out upper line
when reporting plugging
off formations.

Give All Information Completely
Make Required Affidavit
Mail or Deliver Report to:
Conservation Division
State Corporation Commission
800 Bittling Building
Wichita, Kansas

Rooks County. Sec. 21 Twp. 9S Rge. 19W (E) W (W)
Location as "NE $\frac{1}{4}$ NW $\frac{1}{4}$ SW $\frac{1}{4}$ " or footage from lines. NW NW SW
Lease Owner. Lion Oil Company
Lease Name. Mongeau Well No. 1
Office Address. Box 552 Pratt, Kansas
Character of Well (completed as Oil, Gas or Dry Hole) Dry Hole
Date well completed. 4-26 19. 49
Application for plugging filed. 4-26 19. 49
Application for plugging approved. 4-26 19. 49
Plugging commenced. 4-26 19. 49
Plugging completed. 4-26 19. 49
Reason for abandonment of well or producing formation. Dry Hole

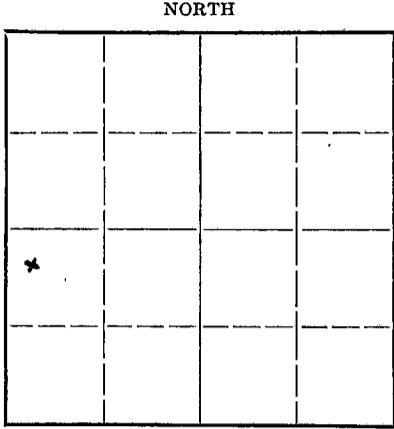

Locate well correctly on above
Section Plat

If a producing well is abandoned, date of last production. 19.
Was permission obtained from the Conservation Division or its agents before plugging was commenced? Yes

Name of Conservation Agent who supervised plugging of this well. Mr. C. D. Stough
Producing formation. Depth to top. Bottom. Total Depth of Well. 3661' Feet
Show depth and thickness of all water, oil and gas formations.

OIL, GAS OR WATER RECORDS

CASING RECORD

Formation	Content	From	To	Size	Put In	Pulled Out
				8 5/8"	297'	
				5 1/2"	3660'	843'

Describe in detail the manner in which the well was plugged, indicating where the mud fluid was placed and the method or methods used in introducing it into the hold. If cement or other plugs were used, state the character of same and depth placed, from feet to feet for each plug set.

Heavy mud to 3321' with 5 sacks of cement
Heavy mud to 300' with 10 sacks of cement on 10' Rock Bridge @ 300'
Heavy mud to 30' with 10 sacks of cement to surface

STAMP: STATE CORPORATION COMMISSION, KANSAS, MAY 5 1949, 5-5-49

(If additional description is necessary, use BACK of this sheet)

Correspondence regarding this well should be addressed to. Lion Oil Company
Address. Box 552 Pratt, Kansas

STATE OF Kansas, COUNTY OF Pratt, ss.
Vernon Hayes (employee of owner) or (owner or operator) of the above-described well,
being first duly sworn on oath says: That I have knowledge of the facts, statements, and matters herein contained and the log of the above-described well as filed and that the same are true and correct. So help me God.

(Signature) Vernon Hayes

Box 552 Pratt, Kansas (Address)

SUBSCRIBED AND SWORN TO before me this 4th day of May, 1949.

My commission expires with office

Notary Public: Patricia Hammig

PLUGGING
MAY 21 9 1949
BY [Signature]

STATE OF KANSAS

INVOICE

May 2, 194 9

To: Lion Oil Company
Pratt, Ks.

STATE CORPORATION COMMISSION
CONSERVATION DIVISION
800 BITTING BUILDING
WICHITA, KANSAS

FOR: PLUGGING ASSESSMENT AS FOLLOWS:

Mongeau Well No. #1
NW NW SW 21-9-19W
File No. 94-5

\$25.00

NOTE: We also need a Written Application, a Well Log and a Well Plugging Record on this well to complete our file.

*Pd. D 22144 (c)
Ch.# 5-21-49
S.S.G.*

TO INSURE CORRECT APPLICATION KINDLY
RETURN PINK COPY WITH REMITTANCE



DRILLER'S LOG

Company: Lion Oil Company

Sec. 21 Twp. 9S Rge. 19W
NW NW SW

Farm: Mongeau Well No., 1

County: Rooks
Kansas

Total Depth: 3661' (Rotary)

Contractor: Glenn Peel Drilling Co., Inc.

Elevation:

Comm.: 3-15-49 Comp.: 3-31-49

Casing:

8 5/8" 297' cem.

5 1/2" 3660' cem.

Figures below indicate bottom of formations

Surface Clay	0 -	70
Sand		100
Shale and Sand		297
Shale and Shells		615
Sand and Shale		660
Shale and Shells		765
Sand		820
Shale, Shells, Pyrite Streaks		980
Sand and Shale		1140
Shale and Shells		1525
Anhydrite		1558
Shale and Shells		1985
Shale and Lime		2085
Lime and Shale		2270
Shale		2285
Lime and Shale		2405
Lime		2602
Lime and Shale		2700
Lime		2830
Lime and Shale		3131
Lime		3155
Lime and Shale		3210
Lime		3621
Lime and Shale		3645
Lime		3661
Total Depth		3661

RECEIVED
Conservation Div.
MAY 5 - 1949 5-5-49
STATE CORPORATION
COMMISSION
KANSAS

This is to certify that the above information is, to the best of our knowledge, true and correct.

GLENN PEEL DRILLING COMPANY, INC.

BY: Wm Herbert

SUBSCRIBED AND SWORN to before me this 6th day of April, 1949

My commission expires June 4, 1951

Marion M. Herbert
Notary Public



PLUGGING
FILE SEC 21 T 9 R 19
ROCK FACE 94 LINES