

15-163-20980-00-00

STATE OF KANSAS
STATE CORPORATION COMMISSION

WELL PLUGGING RECORD

Give All Information Completely
Make Required Affidavit
Mail or Deliver Report to
Conservation Division
State Corporation Comm.
245 North Water
Wichita, KS 67202

Rooks County, Sec. 21 Twp. 9 Rge. 19 E/W
Location as "NE/CNW/SW" or footage from lines
NE NW NE

Lease Owner Eagle Petroleum Corp.
Lease Name Mongeau Well No. 1
Office Address 1400 Douglas Bldg. Wichita, Kansas
Character of Well (Completed as Oil, Gas or Dry Hole) Dry hole


Date Well completed October 29 1979
Application for plugging filed October 29 1979
Application for plugging approved October 29 1979
Plugging commenced October 29 1979
Plugging completed October 29 1979

Reason for abandonment of well or producing formation dry hole

If a producing well is abandoned, date of last production 19

Was permission obtained from the Conservation Division or its agents before plugging was commenced? yes

Name of Conservation Agent who supervised plugging of this well Marion Schmidt
Producing formation _____ Depth to top _____ Bottom _____ Total Depth of Well 3555'
Show depth and thickness of all water, oil and gas formations.

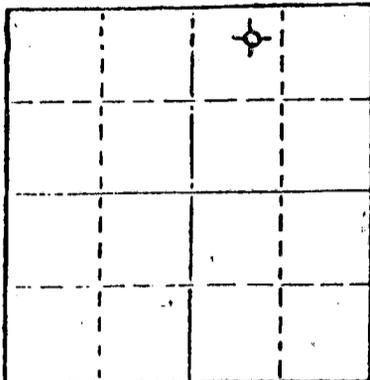

Locate well correctly on above Section Plot

OIL, GAS OR WATER RECORDS

CASING RECORD

FORMATION	CONTENT	FROM	TO	SIZE	PUT IN	PULLED OUT
surface		0	276	8 5/8"	276	0

Describe in detail the manner in which the well was plugged, indicating where the mud fluid was placed and the method or methods used in introducing it into the hold. If cement or other plugs were used, state the character of same and depth placed, from _____ feet to _____ feet for each plug set.

1st Plug at 720' with 70 sacks 50-50 poz 6% gel.

2nd Plug at 270' with 20 sacks 50-50 poz 6% gel.

3rd Plug at 40' with 10 sacks 50-50 poz 6% gel.

5 sacks rathole

(If additional description is necessary, use BACK of this sheet)

Name of Plugging Contractor Allied Gementing Co., Inc.

STATE OF Kansas COUNTY OF Graham, ss.

Jerry M. Helberg (employee of owner) or (owner or operator)

of the above-described well, being first duly sworn on oath, says: That I have knowledge of the facts, statements, and matters herein contained and the log of the above-described well as filed and that the same are true and correct. So help me God.

(Signature) Jerry M. Helberg
Box 32 Morland, Kansas 67650
(Address)

SUBSCRIBED AND SWORN TO before me this 5th day of November, 1979

Faye E. Minium RECEIVED
Notary Public

My commission expires _____



NOV 06 1979
11-6-79
CONSERVATION DIVISION
Wichita, Kansas

15-163-20980-00-00

DRILLERS LOG

MONGEAU #1

CASING RECORD:

8 5/8" set at 276'

TOTAL DEPTH:

3555'

DESCRIPTION:

NE NW NE
Sec. 21-9-19 Rooks County, Kansas

OPERATOR: Eagle Petroleum Corp.

CONTRACTOR: Helberg Oil Company

COMMENCED: October 20, 1979

COMPLETED: October 29, 1979

FORMATION	FROM	TO	REMARKS
Sand & Shale	0	290	
Sand & Shale	290	309	
Shale & Sand	309	1100	
Sand & Shale	1100	1470	
Anhydrite	1470	1510	
Shale & Sand	1510	1945	
Shale & Lime	1945	2205	
Shale & Lime	2205	2309	
Shale & Lime	2309	2459	
Shale & Lime	2459	2621	
Shale & Lime	2621	2716	
Lime & Shale	2716	2870	
Lime & Shale	2868	3012	
Shale & Lime	3012	3106	
Lime & Shale	3106	3152	
Lime & Shale	3152	3227	
Shale & Lime	3227	3310	
Lime & Shale	3310	3340	
Lime & Shale	3340	3428	
Lime & Shale	3428	3500	
Lime & Shale	3500	3540	
Lime & Shale	3540	3555	
T.D.	3555		

11-6-79
D & A

I certify that the above is true and correct copy of the log to the best of my knowledge.

HELBERG OIL COMPANY

Jerry M. Helberg
Jerry M. Helberg

Subscribed and sworn to before me this 5th day of November, 1979.

James E. Johnson
Notary Public

My commission expires  .