


STATE OF KANSAS
STATE CORPORATION COMMISSION

Give All Information Completely
Make Required Affidavit
Mail or Deliver Report to:
Conservation Division
State Corporation Commission
211 No. Broadway
Wichita, Kansas

WELL PLUGGING RECORD

NORTH

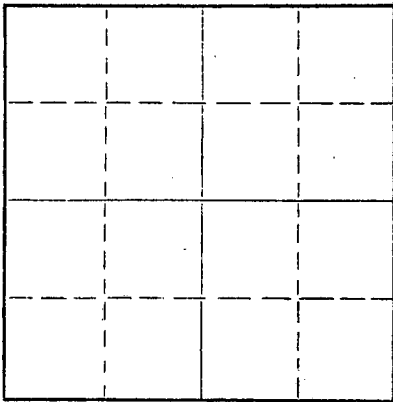

Locate well correctly on above
Section Plat

Rooks

County. Sec. 29 Twp. 9S Rge. 19 (X) (W)

Location as "NE/CNW/SW" or footage from lines C S $\frac{1}{2}$ S $\frac{1}{2}$ SE $\frac{1}{4}$

Lease Owner Leben Drilling, Inc.

Lease Name Desmarteau Well No. 1

Office Address 905 Central Bldg, Wichita, Kansas

Character of Well (completed as Oil, Gas or Dry Hole) D & A

Date well completed 6-28-57 19

Application for plugging filed 6-28-57 19

Application for plugging approved 6-28-57 19

Plugging commenced 6-28-57 19

Plugging completed 6-28-57 19

Reason for abandonment of well or producing formation D & A

If a producing well is abandoned, date of last production --- 19

Was permission obtained from the Conservation Division or its agents before plugging was commenced? Yes

Name of Conservation Agent who supervised plugging of this well Edon Petty

Producing formation --- Depth to top --- Bottom --- Total Depth of Well --- Feet

Show depth and thickness of all water, oil and gas formations.

OIL, GAS OR WATER RECORDS

CASING RECORD

FORMATION	CONTENT	FROM	TO	SIZE	PUT IN	PULLED OUT
				8-5/8"	243'	

Describe in detail the manner in which the well was plugged, indicating where the mud fluid was placed and the method or methods used in introducing it into the hole. If cement or other plugs were used, state the character of same and depth placed, from --- feet to --- feet for each plug set.

1st Plug @ 550' with 25 sx cement.

2nd Plug @ 40' with 10 sx cement to surface.

RECEIVED
STATE CORPORATION COMMISSION

JUL 9 - 1957

CONSERVATION DIVISION
Wichita, Kansas

(If additional description is necessary, use BACK of this sheet)

Name of Plugging Contractor Leben Drilling, Inc.
Address 905 Central Bldg., Wichita, Kansas

7-9-57

STATE OF Kansas, COUNTY OF Sedgwick, ss.
I, Frank Hamlin

(employee of owner) or (owner or operator) of the above-described well, being first duly sworn on oath, says: That I have knowledge of the facts, statements, and matters herein contained and the log of the above-described well as filed and that the same are true and correct. So help me God.

(Signature) Frank Hamlin
905 Central Bldg, Wichita, Kansas

(Address)

SUBSCRIBED AND SWORN TO before me this 8th day of July, 19 57

My commission expires June 17, 1961

Ruth W. Benjamin Notary Public.

PLUGGING

FILE SEC 29 T 9 R 19W
BOOK PAGE 24 LINE 26

CONTRACTOR'S WELL LOG

COMPANY: BANKOFF OIL COMPANY
 CONTRACTOR: LEBEN DRILLING, INC.
 FARM: DESMARTEAU NO. 1
 LOCATION: C S $\frac{1}{2}$ S $\frac{1}{2}$ SE $\frac{1}{4}$ Sec. 29-9S-19W,
 ROOKS COUNTY, KANSAS
 COMMENCED: 6-19-57
 COMPLETED: 6-28-57

0	60	Sand & Clay	TOPS:
60	243	Shale & Shells	Anhydrite 1630
243	900	Shale	Lansing 3451
900	1045	Shale & Sand	Shaly Conglom. 3706
1045	1380	Sand & Shale	Cherty Conglom. 3720
1380	1630	Shale, Shells & Redbed	Arbuckle 3766
1630	1670	Anhydrite	
1670	1850	Shale & Shells	
1850	2025	Shale & Shells	
2025	2240	Shale & Lime	
2240	2410	Shale & Lime	
2410	2550	Shale & Lime	
2550	2705	Shale & Lime	
2705	2840	Shale & Lime	
2840	2930	Shale & Lime	
2930	3125	Shale & Lime	
3125	3285	Shale & Lime	
3285	3355	Shale & Lime	
3355	3405	Lime & Shale	
3405	3485	Lime & Shale	
3485	3515	Lime	
3515	3565	Lime	
3565	3615	Lime	
3615	3632	Lime	
3632	3660	Lime & Conglomerate	
3660	3725	Lime & Conglomerate	
3725	3756	Lime & Shale	
3756	3795	Lime & Shale	
	<u>3795</u>	Rotary Total Depth D & A	

Set 8 5/8" surface casing at 243' with 160 sacks cement, 3 sx CaCl.

I, Frank Hamlin, do hereby certify that the above and foregoing is a true and correct copy of the log of the Desmarteau #1, C S $\frac{1}{2}$ S $\frac{1}{2}$ SE $\frac{1}{4}$ of Section 29, Township 9 South, Range 19 West, Rooks County, Kansas, as reflected by the files of Leben Drilling, Inc.

LEBEN DRILLING, INC.

BY: Frank Hamlin
 Frank Hamlin

STATE OF KANSAS } ss.
 COUNTY OF SEDGWICK }

Subscribed and sworn to before me, a Notary Public, in and for Sedgwick County, Kansas, this 8th day of July, 1957.

Ruth N. Benjamin
 Ruth N. Benjamin-Notary Public

My commission expires June 17, 1961.

ED 7-9-57
 COMMISSION

JUL 9 1957
 CONSERVATION DIVISION
 Wichita, Kansas

PLUGGING
 FILE SEC 29 T 9 R 19W
 BOOK PAGE 24 LINE 26