

15-163-00010-00-00

STATE OF KANSAS
STATE CORPORATION COMMISSION

Give All Information Completely
Make Required Affidavit
Mail or Deliver Report to:
Conservation Division
State Corporation Commission
211 No. Broadway
Wichita, Kansas

WELL PLUGGING RECORD

Rooks County, Sec. 29 Twp. 9 Rge. 19 ~~NE~~ (W)

Location as "NE/CNW/SW" or footage from lines SW NE SW

Lease Owner Woodman & Iannitti Drilling Co.

Lease Name Desmarteau Well No. 1

Office Address 714 Union Nat'l. Bldg., Wichita

Character of Well (completed as Oil, Gas or Dry Hole) dry hole

Date well completed March 25 1962

Application for plugging filed March 25 1962

Application for plugging approved March 25 1962


Plugging commenced March 25 1962

Plugging completed March 25 1962

Reason for abandonment of well or producing formation

If a producing well is abandoned, date of last production 19

Was permission obtained from the Conservation Division or its agents before plugging was commenced? yes

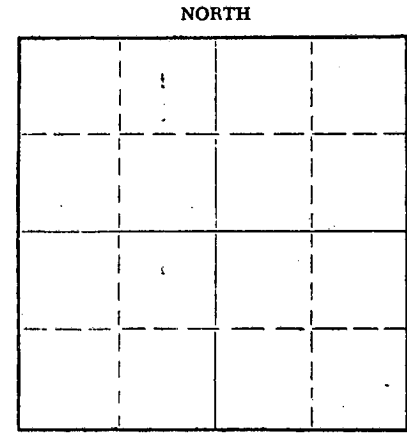

Locate well correctly on above Section Plat

Name of Conservation Agent who supervised plugging of this well Eldon Petty

Producing formation Depth to top Bottom Total Depth of Well 3713' Feet

Show depth and thickness of all water, oil and gas formations.

OIL, GAS OR WATER RECORDS

CASING RECORD

FORMATION	CONTENT	FROM	TO	SIZE	PUT IN	PULLED OUT
				8 5/8	185'	

Describe in detail the manner in which the well was plugged, indicating where the mud fluid was placed and the method or methods used in introducing it into the hole. If cement or other plugs were used, state the character of same and depth placed, from feet to feet for each plug set.

Bottom plug @ 550' w/20 sx cement
Middle plug @ 180' w/20 sx cem.
Top plug @ 35' w/10 sx cement

RECEIVED
STATE CORPORATION COMMISSION

MAR 27 1962

CONSERVATION DIVISION
Wichita, Kansas

3-27-62

(If additional description is necessary, use BACK of this sheet)

Name of Plugging Contractor Woodman & Iannitti Drilling Co.

Address 714 Union Nat'l. Bldg., Wichita

STATE OF Kansas, COUNTY OF Sedgwick, ss.

K. T. Woodman (employee of owner) or (owner or operator) of the above-described well, being first duly sworn on oath, says: That I have knowledge of the facts, statements, and matters herein contained and the log of the above-described well as filed and that the same are true and correct. So help me God.

(Signature) K. T. Woodman

714 Union Nat'l. Bldg.
(Address)

SUBSCRIBED AND SWORN to before me this 27th day of March, 1962

Frances H. Solomon
Notary Public.

My commission expires Oct. 10, 1963



FRANCES H. SOLOMON

DRILLING LOG

Company: Woodman & Iannitti Drilling Company
 Lease #1 DESMARTEAU SW NE SW 29-9-19W, Rooks County, Kansas
 Contractor: Woodman & Iannitti Drilling Company
 Date Commenced: 3-16-62
 Date Completed: 3-25-62
 Total Depth: 3715'
 Casing: 8 5/8" @ 185' with 130 sacks cement

Figures Indicate the Bottom of Formation

0 - 160	Clay & Sand
185	Blue Shale
700	Shale
1060	Shale & streak of Sand
1270	Sand
1581	Red Bed
1615	Anhydrite
1805	Shale
2180	Shale & Shells
3655	Lime
3713	Conglomerate

STATE OF KANSAS
 MAR 2 1962
 DEPARTMENT OF REVENUE
 3-27-62

I certify the above to be a true and correct copy of the Driller's Log to the best of my knowledge and belief.

WOODMAN & IANNITTI DRILLING COMPANY

By K. T. Woodman
 K. T. Woodman

KTW/fs