


15-103-00621-00-00

STATE OF KANSAS  
STATE CORPORATION COMMISSION

WELL PLUGGING RECORD

Give All Information Completely  
Make Required Affidavit  
Mail or Deliver Report to:  
Conservation Division  
State Corporation Commission  
800 Biting Building  
Wichita, Kansas

Rooks County. Sec. 36 Twp. 9S Rge. 19W (#) (W)  
Location as "NE/CNW/SW" or footage from lines SE SE NW  
Lease Owner Mid Plains Oil Corporation  
Lease Name Thomas Well No. 1  
Office Address 921 Union National Bank Building, Wichita, Kansas  
Character of Well (completed as Oil, Gas or Dry Hole) Dry Hole  
Date well completed January 7 1953  
Application for plugging filed January 7 19 53  
Application for plugging approved January 7 19 53  
Plugging commenced 4:00 p.m., January 7 19 53  
Plugging completed 11:30 p.m., January 7 19 53  
Reason for abandonment of well or producing formation Commercial quantity  
of oil not found  
If a producing well is abandoned, date of last production 19  
Was permission obtained from the Conservation Division or its agents before plugging was commenced? Yes

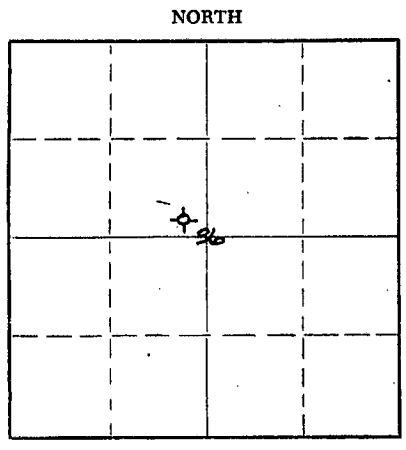

Locate well correctly on above Section Plat

Name of Conservation Agent who supervised plugging of this well Eldon Petty  
Producing formation \_\_\_\_\_ Depth to top \_\_\_\_\_ Bottom \_\_\_\_\_ Total Depth of Well 3832 Feet  
Show depth and thickness of all water, oil and gas formations.

OIL, GAS OR WATER RECORDS

CASING RECORD

FORMATION	CONTENT	FROM	TO	SIZE	PUT IN	PULLED OUT
				8 5/8"	206'	None

Describe in detail the manner in which the well was plugged, indicating where the mud fluid was placed and the method or methods used in introducing it into the hole. If cement or other plugs were used, state the character of same and depth placed, from \_\_\_\_\_ feet to \_\_\_\_\_ feet for each plug set.


Two plugs set at 200' and 40' cemented with 25 sacks cement  
1/2 sack hulls. Cemented to top of surface pipe.

RECEIVED  
STATE CORPORATION COMMISSION

JAN 16 1953 1-16-53

(If additional description is necessary, use BACK of this sheet) CONSERVATION DIVISION

Name of Plugging Contractor K & E Drilling, Inc. Wichita, Kansas  
Address 1006 Central Building, Wichita, Kansas

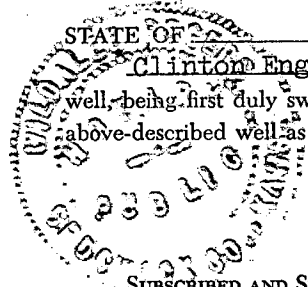

Kansas, COUNTY OF Sedgwick, ss.  
Clinton Engstrand, agent for \_\_\_\_\_ (owner or operator) of the above-described well, being first duly sworn on oath, says: That I have knowledge of the facts, statements, and matters herein contained and the log of the above-described well as filed and that the same are true and correct. So help me God.

(Signature) Clinton Engstrand  
1006 Central Building, Wichita, Kansas  
(Address)

SUBSCRIBED AND SWORN to before me this 15 day of January, 19 53

Hildale Rogers  
Notary Public.

My commission expires October 29, 1955

PLUGGING  
FILE SEC 367-9-1953  
BOOK PAGE 71 LINE 44

