

STATE OF KANSAS  
 STATE CORPORATION COMMISSION  
 200 Colorado Derby Bldg.  
 Wichita, Kansas 67202


Form CP-4  
 Rev. 12-15-80

WELL PLUGGING RECORD

15-163-22151-00-00

Give All Information Completely  
 Make Required Affidavit

COUNTY Rooks SEC. 1 TWP. 9S RGE. 20W E/W  
 Location as in quarters or footage from lines:  
NW/4 SE/4 SW/4

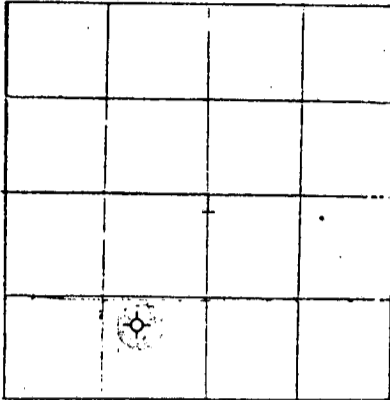

Locate Well  
 correctly on above  
 Section Platt.

Lease Owner Gear Petroleum Company, Inc.  
 Lease Name Georgia Well No. 1-1  
 Office Address 300 Sutton Place, Wichita, Kansas 67202  
 Character of Well (Completed as Oil, Gas or Dry Hole): D & A (C)(L)  
 Date Well Completed October 12, 1983  
 Application for plugging filed October 12, 1983  
 Plugging commenced October 12, 1983  
 Plugging completed October 12, 1983  
 Reason for abandonment of well or producing formation D & A

Was permission obtained from the Conservation Division or it's  
 Agent's before plugging was commenced? yes

Name of Conservation Agent who supervised plugging of this well Gilbert Scheck

Producing formation \_\_\_\_\_ Depth to top \_\_\_\_\_ bottom \_\_\_\_\_ T.D. 3,650'

Show depth and thickness of all water, oil and gas formations.

OIL, GAS OR WATER RECORDS

Casing Record

Formation	Content	From	To	Size	Put in	Pulled Out
				8 5/8"	314.98'	-0-


Describe in detail the manner in which the well was plugged, indicating where the mud  
 fluid was placed and the method or methods used in introducing it into the hold. If cement  
 or other plugs were used, state the character of same and depth placed, from \_\_\_\_\_ feet  
 to \_\_\_\_\_ feet for each plug set.

- 1st Plug @ 1575' w/20 sx cement
- 2nd Plug @ 900' w/100 sx cement
- 3rd Plug @ 375' w/40 sx cement
- 4th Plug @ 40' w/10 sx cement
- 10 sx cement in rathole
- 50/50 Pozmix, 6% Gel, 3% C.C.

RECEIVED  
 STATE CORPORATION COMMISSION  
 OCT 20 1983  
 CONSERVATION DIVISION  
 Wichita, Kansas

(If additional description is necessary, use BACK of this sheet)  
 Name of Plugging Contractor Allied Cementing Company, Inc. 1020-83

STATE OF Kansas COUNTY OF Sedgwick, ss.  
Jim Thatcher, Drlg & Prod. Mgr (employee of owner) or (owner or operator) of the  
 above-described well, being first duly sworn on oath, says: That I have knowledge of the  
 facts, statements, and matters herein contained and the log of the above-described well as  
 filed and that the same are true and correct. So help me God.

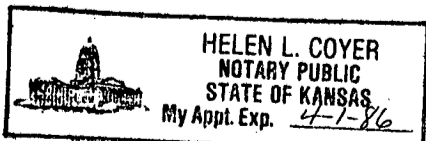

(Signature) Jim Thatcher  
300 SUTTON PLACE WICHITA KS 67202  
 (Address)

SUBSCRIBED AND SWORN TO before me this 19th day of October, 19 83

Helen L. Coyer  
 Notary Public.

My Commission expires: April 1, 1986

Helen L. Coyer