


15-163-00404-00-00

Give All Information Completely  
Make Required Affidavit  
Mail or Deliver Report to:  
Conservation Division  
State Corporation Commission  
800 Bittling Building  
Wichita, Kansas

WELL PLUGGING RECORD

Rooks County, Sec. 9, Twp. 9, Rge. (E) 18 (W)  
Location as "NE/CNW $\frac{1}{4}$ SW $\frac{1}{4}$ " or footage from lines NE $\frac{1}{4}$  NE $\frac{1}{2}$  SE $\frac{1}{4}$   
Lease Owner Isern Drilling Company et al  
Lease Name Holl Well No. 1  
Office Address Box 92, Ellinwood, Kansas  
Character of Well (completed as Oil, Gas or Dry Hole) Dry Hole  
Date well completed 7-17-51 19  
Application for plugging filed 7-17-51 19  
Application for plugging approved 7-17-51 19  
Plugging commenced 7-17-51 19  
Plugging completed 7-17-51 19  
Reason for abandonment of well or producing formation Dry Hole

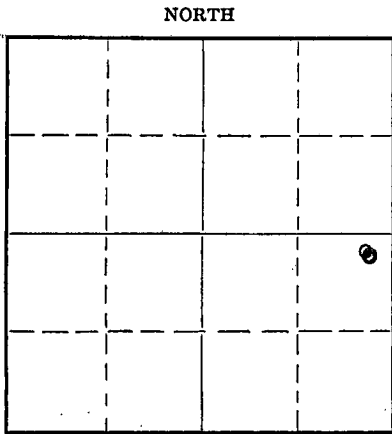

Locate well correctly on above Section Plat

If a producing well is abandoned, date of last production 19  
Was permission obtained from the Conservation Division or its agents before plugging was commenced? Yes

Name of Conservation Agent who supervised plugging of this well Eldon Petty  
Producing formation Depth to top Bottom Total Depth of Well 3660 Feet  
Show depth and thickness of all water, oil and gas formations.

OIL, GAS OR WATER RECORDS

CASING RECORD

Formation	Content	From	To	Size	Put In	Pulled Out
Surface Pipe		0	181	8-5/8"	181	None

Describe in detail the manner in which the well was plugged, indicating where the mud fluid was placed and the method or methods used in introducing it into the hole. If cement or other plugs were used, state the character of same and depth placed, from feet to feet for each plug set.

Mudded hole with heavy mud to 175'. Set plug and cemented with 15 sacks cement.  
Mudded hole to 40' with heavy mud. Set plug and cemented with ten sacks cement, cement returning to base of cellar.

(If additional description is necessary, use BACK of this sheet)

Correspondence regarding this well should be addressed to G. W. Keyes Drilling Compy  
Address Box 92, Ellinwood, Kansas

STATE OF KANSAS, COUNTY OF BARTON, ss.  
Edw. H. Isern, Partner Owner (partner or owner or operator) of the above-described well, being first duly sworn on oath, says: That I have knowledge of the facts, statements, and matters herein contained and the log of the above-described well as filed and that the same are true and correct. So help me God.

(Signature) *Edw. H. Isern*  
Ellinwood, Kansas (Address)

SUBSCRIBED AND SWORN to before me this 25th day of July, 1951  
My commission expires Feb. 10, 1955.

RECEIVED  
STATE CORPORATION COMMISSION  
JUL 26 1951  
Notary Public. *Meyer*

PLUGGING  
FILE SEC 9 T 9 R 18  
BOOK PAGE PAGE 3

CONSERVATION DIVISION  
Wichita, Kansas

7-26-51

WELL LOG

ISERN DRILLING COMPANY et al, OWNERS - Holl #1  
NE 1/4 NE 1/4 SE 1/4 Section 9, Township 9S, Range 18W.  
Rooks County, Kansas

Elevation: 2033 DF	Figures indicate bottom of formation
	0 to 41 surface clay
	115 shale and sand
Pipe Record:	140 sand and gravel
	715 shale and shells
8-5/8" set at 181'	932 sand and shale
	1180 sand
	1200 sand and shale
Tops, corrected 2' to derrick floor	1423 red bed and shale
	1435 red bed
Heebner 3209'	1460 anhydrite
Toronto 3230'	1930 shale and shells
Lansing 3248'	2069 lime and shale
Base K. C. 3434'	2265 shale and lime
Conglomerate 3504'	2660 lime and shale
Arbuckle 3617'	2997 shale and lime
	3100 lime and shale
	3525 lime
Rotary commenced 7- 8-51	3619 conglomerate
Rotary completed 7-17-51	3660 arbuckle
	3660 Total Depth D & A

STATE OF KANSAS )  
COUNTY OF BARTON ) SS

I, Edw. H. Isern, Part Owner of the above-described well, being first duly sworn on oath, declare: That I have knowledge of the facts, statements and matters herein contained pertaining to the log of the above-described well as filed, and that the same are true and correct.

*Edw. H. Isern*

Subscribed and Sworn to before me this 25th day of July, 1951.

*George A Meyer*  
Notary Public

STATE OF KANSAS  
NOTARY PUBLIC

My commission expires Feb. 10, 1956

JUL 25 1951  
NOTARY PUBLIC DIVISION  
Wichita, Kansas

7-26-51

9-9-186  
97-103