

15-163-00390-00-00

STATE OF KANSAS  
STATE CORPORATION COMMISSION


WELL PLUGGING RECORD

Give All Information Completely  
Make Required Affidavit  
Mail or Deliver Report to:  
Conservation Division  
State Corporation Commission  
800 Bittling Building  
Wichita, Kansas

Rocks: \_\_\_\_\_ County. Sec. 11 Twp. 9S Rge. 18 ~~705~~ (W)

Location as "NE/CNW $\frac{1}{4}$ SW $\frac{1}{4}$ " or footage from lines NW NW SW  
Lease Owner THE PALMER OIL CORP. & PICKRELL DRILLING COMPANY, INC.  
Lease Name WILSON Well No. 1  
Office Address 415 Union National Bank Building, Wichita, Kansas  
Character of Well (completed as Oil, Gas or Dry Hole) Dry Hole  
Date well completed 10/10 19 50  
Application for plugging filed 10/10 19 50  
Application for plugging approved 10/10 19 50  
Plugging commenced 10/10 19 50  
Plugging completed 10/10 19 50  
Reason for abandonment of well or producing formation D & A.

NORTH

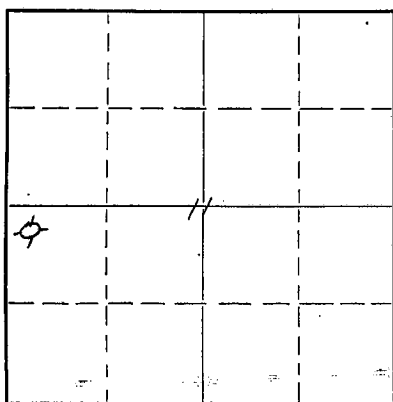

Locate well correctly on above  
Section Plat

If a producing well is abandoned, date of last production 19  
Was permission obtained from the Conservation Division or its agents before plugging was commenced? Yes

Name of Conservation Agent who supervised plugging of this well Eldon Petty  
Producing formation \_\_\_\_\_ Depth to top \_\_\_\_\_ Bottom \_\_\_\_\_ Total Depth of Well 3625' Feet  
Show depth and thickness of all water, oil and gas formations.

OIL, GAS OR WATER RECORDS

CASING RECORD

Formation	Content	From	To	Size	Put In	Pulled Out
				8 5/8"	132'	None

Describe in detail the manner in which the well was plugged, indicating where the mud fluid was placed and the method or methods used in introducing it into the hole. If cement or other plugs were used, state the character of same and depth placed, from \_\_\_\_\_ feet to \_\_\_\_\_ feet for each plug set.

~~Filled hole with heavy mud from 3625' to 120'. Set bridge and dumped 10 sacks cement. Filled with mud to 35'. Set bridge and filled with 10 sacks cement to bottom of cellar.~~

(If additional description is necessary, use BACK of this sheet)

Correspondence regarding this well should be addressed to PICKRELL DRILLING COMPANY, INC.  
Address 705 Fourth National Bank Building, Wichita 2, Kansas

STATE OF Kansas, COUNTY OF Sedgwick, ss.  
JOSEPH B. BRUNGARDT, JR. (employee of owner) or ~~owner or operator~~ of the above-described well,  
being first duly sworn on oath, says: That I have knowledge of the facts, statements, and matters herein contained and the log of the above-described well as filed and that the same are true and correct. So help me God.

(Signature) Joseph B. Brungardt, Jr.  
705 Fourth Natl Bank Bldg., Wichita 2, Kansas  
(Address)



SUBSCRIBED AND SWORN to before me this 23rd day of October, 19 50  
My commission expires January 28, 1953.  
E. J. ... Notary Public.

**PLUGGING**  
FILE SEC 11-9-R-186  
BOOK PAGE 33 LINE 48

22-7377-s 4-49-10M

**RECEIVED**  
OCT 24 1950  
CONSERVATION DIVISION  
Wichita, Kansas  
10-24-50

15-163-00390-00.00

COMPANY: THE PALMER OIL CORPORATION Rotary Drilling Commenced: 10- 1-50  
 and PICKRELL DRILLING COMPANY, INC. Rotary Drilling Completed: 10-10-50

LOCATION: WILSON #1  
 NW NW SW Section 11-9S-18W  
 Rooks County, Kansas

CONTRACTOR: PICKRELL DRILLING COMPANY, INC.  
 Wichita, Kansas

CASING RECORD: 132' (4 Jts.) 8 5/8" 24# seamless casing set at 132' in a 12 1/4" hole, cemented with 80 sacks cement.

Drilled 7 7/8" hole from 132' to 3625' T.D. No oil string run.

LOG

(Figures indicate bottom formation - Measurements from top rotary bushing.)

Cellar	5	Circulate for samples at 3516'.
Shale & Shells	132	" " " " 3520'.
Shale, Shells & Sand Strs.	925	
Sand	1160	Slope test at 500' - 0° off.
Shale, Shells & Sand Strs.	1345	Slope test at 1000' - 0° off.
Shale & Shells	1450	S.L.M. at 1500' - 10' uphole cor- rection from 1542' to 1532'.
Anhydrite	1485	Slope test at 2000' - 0° off.
Shale & Shells	1980	Slope test at 2500' - 0° off.
Shale & Lime	2180	Slope test at 3000' - 0° off.
Brown Lime & Shale Str.	2220	S.L.M. at 3100' - O.K.
Shale & Lime	3000	S.L.M. at 3625' - O.K.
Lime	3475	
Lime & Chert	3520	Lost Circulation at 3237'.
Cherty Lime	3545	Lost Circulation at 3244'.
Lime & Conglomerate	3577	
Lime-Arbuckle	3620	
Dolomite	3625 Rotary T.D.	

The undersigned, C. W. Sebits, Secretary of PICKRELL DRILLING COMPANY, INC., hereby certifies in behalf of said corporation, that the above log is a true and correct log of the formation encountered in drilling the above well as reflected by the Daily Drilling Reports.


PICKRELL DRILLING COMPANY, INC.  
 By C. W. Sebits  
 Secretary

STATE OF KANSAS )  
 ) ss  
 COUNTY OF SEDGWICK)

BE IT REMEMBERED that on this 23rd day of October, 1950, before me, the undersigned, a Notary Public, duly commissioned, in and for the county and state aforesaid, came C. W. Sebits, Secretary of Pickrell Drilling Company, Inc., a corporation of the State of Kansas, personally known to me to be such officer, and to be the same person who executed as such officer the foregoing instrument of writing in behalf of said corporation, and he duly acknowledged the execution of the same for himself and for said corporation.

IN WITNESS WHEREOF, I have hereunto set my hand and official seal on the day and year last above written.

Ethel Zimmerman  
 Notary Public

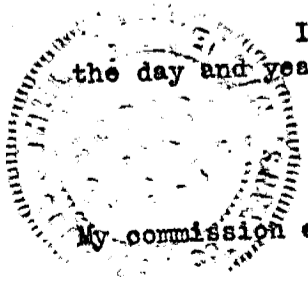

My commission expires January 28, 1953.

RECEIVED  
 STATE CORPORATION COMMISSION  
 OCT 24 1950  
 CONSERVATION DIVISION  
 Wichita, Kansas

10-24-50

PLUGGING  
 FILE SEC 11 T 9 R 18 W  
 BOOK PAGE 33 LINE 44