

15-163-00792-00-01

STATE OF KANSAS  
STATE CORPORATION COMMISSION

Give All Information Completely.  
Make Required Affidavit  
Mail or Deliver Report to:  
Conservation Division  
State Corporation Commission  
211 No. Broadway  
Wichita, Kansas

WELL PLUGGING RECORD

Rooks County, Sec. 14 Twp. 9S Rge. (E) 18W (W)

Location as "NE/CN W&SW" or footage from lines NE NE NE

Lease Owner Jay Bergman Oil Company

Lease Name OBrien Well No. 1

Office Address 425 Union Center Bldg., Wichita 2, Kansas

Character of Well (completed as Oil, Gas or Dry Hole) oil well - wash down

Date well completed May 13 19 60

Application for plugging filed July 25 19 61

Application for plugging approved July 25 19 61


Plugging commenced August 25 19 61

Plugging completed August 25 19 61

Reason for abandonment of well or producing formation Old well wash down - non commercial

If a producing well is abandoned, date of last production 19

Was permission obtained from the Conservation Division or its agents before plugging; was commenced? yes

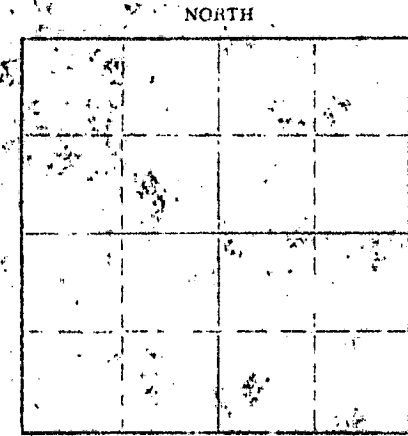

Name of Conservation Agent who supervised plugging of this well Eldon Petty

Producing formation Depth to top Bottom Total Depth of Well Feet

Show depth and thickness of all water, oil and gas formations.

OIL, GAS OR WATER RECORDS

CASING RECORD

FORMATION	CONTENT	FROM	TO	SIZE	PUT IN	PULLED OUT
				5"		3132

Describe in detail the manner in which the well was plugged, indicating where the mud fluid was placed and the method or methods used in introducing it into the hole. If cement or other plugs were used, state the character of same and depth placed, from feet to feet for each plug set.

Pumped 18 sacks mud and 20 sax cement.  
Pumped 20 sax cement at 200 feet, dumped 10 sacks cement.

LOG NOT AVAILABLE FILED BY  
HOUSTON PETROLEUM OR CHIEF  
DRILLING CO.

RECEIVED  
STATE CORPORATION COMMISSION  
APR 2 1962  
CONSERVATION DIVISION

4-2-62

(If additional description is necessary, use back of this sheet)

Name of Plugging Contractor Wilson, Inc.

Address 317 No. Buffalo, Stafford Kansas

STATE OF Kansas COUNTY OF SEDGWICK

Harold Bergman (employee of owner) or (owner or operator) of the above-described well, being first duly sworn on oath, says: That I have knowledge of the facts, statements, and matters herein contained and the log of the above-described well as filed and that the same are true and correct. So help me God.

(Signature) Harold Bergman  
425 Union center Bldg., Wichita 2, Kansas  
(Address)

Subscribed and sworn to before me this 30 day of August 19 61

My Commission Expires August 2, 1962  
Notary Public

