

15-163-20009-00-00

STATE OF KANSAS
STATE CORPORATION COMMISSION


Form CP-4

Give All Information Completely
Make Required Affidavit
Mail or Deliver Report to:
Conservation Division
State Corporation Commission
212 No. Market
Wichita, Kansas

WELL PLUGGING RECORD

ROOKS County, Sec. 14 Twp. 9S Rge. 18 (E) (W)

Location as "NE/CNW&SW" or footage from lines NW NE NE
Lease Owner PETROLEUM, INC.
Lease Name O'BRIEN 'D' Well No. 1
Office Address R.R. #2, GREAT BEND, KANSAS
Character of Well (completed as Oil, Gas or Dry Hole) DRY HOLE
Date well completed MARCH 17 1967
Application for plugging filed MARCH 17 1967
Application for plugging approved MARCH 17 1967
Plugging commenced MARCH 17 1967
Plugging completed MARCH 17 1967
Reason for abandonment of well or producing formation NO PRODUCTIBLE ZONES

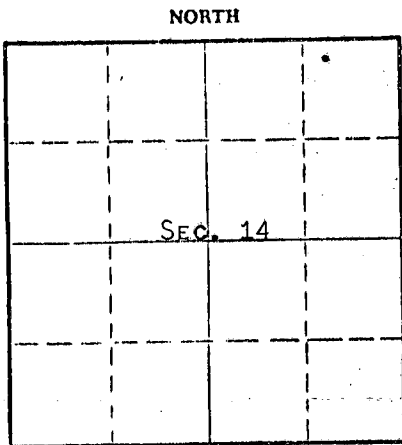

Locate well correctly on above
Section Plat

If a producing well is abandoned, date of last production NONE 19
Was permission obtained from the Conservation Division or its agents before plugging was commenced? YES

Name of Conservation Agent who supervised plugging of this well LEO F. MASSEY
Producing formation _____ Depth to top _____ Bottom _____ Total Depth of Well 3230 Feet
Show depth and thickness of all water, oil and gas formations.

OIL, GAS OR WATER RECORDS

CASING RECORD

FORMATION	CONTENT	FROM	TO	SIZE	PUT IN	PULLED OUT
				8-5/8	213	NONE

Describe in detail the manner in which the well was plugged, indicating where the mud fluid was placed and the method or methods used in introducing it into the hole. If cement or other plugs were used, state the character of same and depth placed, from _____ feet to _____ feet for each plug set.

MUD TO 540', FOLLOWED BY WOODEN PLUG, PLACED 20 SACKS CEMENT ON TOP OF PLUG.
MUD TO 210', FOLLOWED BY WOODEN PLUG, PLACED 20 SACKS CEMENT ON TOP OF PLUG.
MUD TO 40', FOLLOWED BY WOODEN PLUG, PLACED 1 SACK DRY CEMENT, 1/2 SACK HULLS,
7 SACKS CEMENT TO BASE OF WELL CELLAR.

RECEIVED
STATE CORPORATION COMMISSION

MAR 29 1967

CONSERVATION DIVISION
Wichita, Kansas

(If additional description is necessary, use BACK of this sheet)

Name of Plugging Contractor GARVEY DRILLING COMPANY
Address R.R. #2, GREAT BEND, KANSAS


3-29-67

STATE OF KANSAS COUNTY OF BARTON, ss.
MONTE CHADD (employee of owner) or (owner/operator) of the above-described well, being first duly sworn on oath, says: That I have knowledge of the facts, statements, and matters herein contained and the log of the above-described well as filed and that the same are true and correct. So help me God. MONTE CHADD, DIST. PROD. SUPT.

(Signature)

R.R. #2, GREAT BEND, KANSAS
(Address)

SUBSCRIBED AND SWORN to before me this 28 day of MARCH, 1967

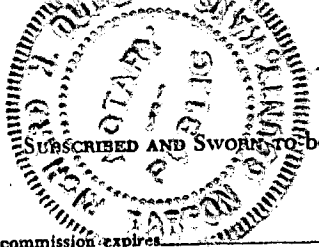

Richard W. Dumber
Notary Public.

My commission expires

MAY 28, 1969

WELL LOG

15-163-20009-00-00

COMPANY Petroleum, Inc.

SEC. 14 T. 9S R. 18W

FARM O'Brien

NO. D-1

LOC. NW NE NE


TOTAL DEPTH 3230'

COUNTY Rooks

COMM. 3-13-67

COMP. 3-18-67

CONTRACTOR Garvey Drilling Company

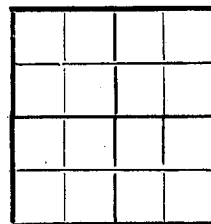

CASING 8 5/8" @ 213' w/175 SX

ELEVATION 2069' DF

PRODUCTION D & A

FIGURES INDICATE BOTTOM OF FORMATIONS


- 75' Surface Clay and Sand
- 213' Shale and Shells
- 740' Red Bed
- 1393' Shale and Sands
- 1435' Anhydrite
- 1470' Shale
- 1720' Shale and Shells
- 1880' Sand and Shale
- 2295' Shale and Lime
- 2710' Lime and Shale
- 3205' Shale with Lime
- 3230' Lime and Shale
- 3230' RTD

RECEIVED
 STATE CORPORATION COMMISSION
 MAR 29 1967
 3-29-67
 CONSERVATION DIVISION
 Wichita, Kansas

State of Kansas }
 County of Barton } ss

I, Sam N. Stephens of Garvey Drilling Company

upon oath state the above and foregoing is a true and correct copy of the log of the O'Brien D-1 well.

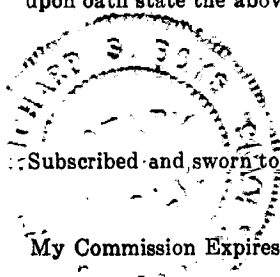

Sam N. Stephens

Subscribed and sworn to before me this 22nd day of March 19 67

My Commission Expires: November 5th, 1969

Richard H. Boyd
 NOTARY PUBLIC