

15-163-03237-00-00


STATE OF KANSAS
STATE CORPORATION COMMISSION

Give All Information Completely
Make Required Affidavit
Mail or Deliver Report to:
Conservation Division
State Corporation Commission
800 Bittling Building
Wichita, Kansas

WELL PLUGGING RECORD

Rooks County, Sec. 16 Twp. 9 Rge. (E) 18 (W)
Location as "NE/CNW 1/4 SW 1/4" or footage from lines Center SW NE SE
Lease Owner Cities Service Oil Co.
Lease Name Kaba Well No. 4
Office Address Bartlesville, Oklahoma
Character of Well (completed as Oil, Gas or Dry Hole) Dry Hole
Date well completed 11-17-53 19
Application for plugging filed 11-17-53 19
Application for plugging approved 11-17-53 19
Plugging commenced 11-18-53 19
Plugging completed 11-18-53 19
Reason for abandonment of well or producing formation

NORTH

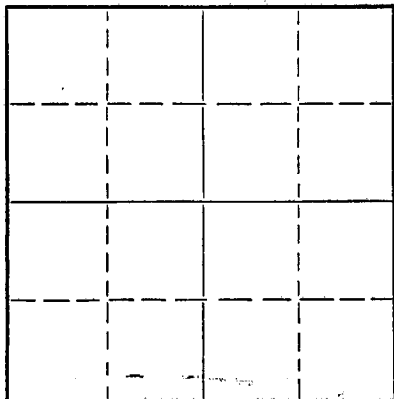

Locate well correctly on above
Section Plat

If a producing well is abandoned, date of last production 19
Was permission obtained from the Conservation Division or its agents before plugging was commenced? YES

Name of Conservation Agent who supervised plugging of this well Mr. Eldon Petty
Producing formation Arbuckle Depth to top 3565' Bottom Total Depth of Well 3574' Feet
Show depth and thickness of all water, oil and gas formations.

OIL, GAS OR WATER RECORDS

CASING RECORD

Formation	Content	From	To	Size	Put In	Pulled Out
Arbuckle	dry			8-5/8	248'	0

Describe in detail the manner in which the well was plugged, indicating where the mud fluid was placed and the method or methods used in introducing it into the hole. If cement or other plugs were used, state the character of same and depth placed, from feet to feet for each plug set.

Fill with heavy mud to 235', set plug with 15 sacks cement on plug.
Heavy mud to 40', set plug with one-half sack hulls and ten sacks
cement on plug to surface.

RECEIVED
STATE CORPORATION COMMISSION
CONSERVATION DIVISION
WICHITA, KANSAS
12-3-53

(If additional description is necessary, use BACK of this sheet)
Name of Plugging Contractor Lohmann-Johnson
Address Evansville, Indiana

STATE OF KANSAS, COUNTY OF BARTON, ss.
James Porter (employee of owner) or (owner or operator) of the above-described well,

being first duly sworn on oath, says: That I have knowledge of the facts, statements, and matters herein contained and the log of the above-described well as filed and that the same are true and correct. So help me God.

(Signature) James Porter
Box 553, Russell, Kansas (Address)

SUBSCRIBED AND SWORN to before me this 23rd day of November, 1953
N. B. Smith Notary Public.

My commission expires 3-17-1955 23-8390-s 6-51-20M

PLUGGING
FILE SEC 16 T 9 R 18 W
BOOK PAGE 145 LINE 11

WELL RECORD

Company Cities Service Oil Co. Well No. 4 Farm Koba
 Location 990' South and 990' West of E/4 Cor. Sec. 16 T. 9 R. 16W
 Elevation 2113 (2110 Gr.) County Neosho State Kansas
 Drlg. Comm. November 5, 1953 Contractor Lohmann-Johnson Drilling Co., Inc.
 Drlg. Comp. November 17, 1953 Acid None
 T. D. 3574' Initial Prod. Dry Hole - P. & A. 11-18-53

CASING RECORD:

8-5/8" @ 248' con. 175 ex cement

FORMATION RECORD:

sand & shale	0-248
shale	660
shale & shells	920
sand & shells	1205
shale & red bed	1448
anhydrite	1481
shale & shells	2230
shale & lime	2400
lime	2530
lime & shale	2655
lime	2717
lime & shale	3017
lime	3265
lime & shale	3310
lime	3520
lime & shale	3574 T. D.

Topoka	3011'
Hoebner	3254'
Dodge	3275'
Lansing	3294'
Arbuckle	3563'
Penetration	9'
Total Depth	3574'

Drill stem test 3378-95, open 1 hr.; recovered 410' slightly oil-cut muddy salt water; B. H. P. 1200#/15 mins.

Drill stem test 3566-74, open 1 hr.; recovered 640' salt water; B. H. P. 550#/15 mins.

GLOPE TESTS (ACID BOTTLE):

500'	00
1000'	00
1500'	00
2000'	00
2500'	00
3000'	00

7-7/8" rotary hole.

PLUGGING
 FILE SEC 16 T 9 R 16W
 BOOK PAGE 145 LINK 11

RECEIVED
 STATE CORPORATION COMMISSION
 DEC 30 1953
 CONSERVATION DIVISION
 Wichita, Kansas
 12-3-53